

Name Wilbur E. Neal

Service No. 82

Address 107 Cedar Street

Location

Common 9/30/57

Kind of Pipe

Size

Size of Main

~~Repair~~ ~~Renewal~~ - New Service

Location

Date	Material	Amount	Total	Date	Amount
7/1/57	Labor	38 92		6-21-57	Deposit \$300 00
7/2/57	"	61 79		9-30-57	Refund 41 03
		100 71			\$258 97
	10% overhead	10 07	110 78		
	110' - 6" Transite Pipe @ .7020		77 22		
	2 Cesspool covers & frames @10.50		21 00		
	2 bags Cement @ 1.27		2 54		
	100 Sewer Brick @ 38.00/1000		3 80		
	1 - 6" V. C. Elbow		1 88		
	14x3 Patch		14 00		
	3 hrs. Town Shovel @ 6.50		19 50		
	3 hrs. Trucking @ .75		2 25		
	1 hr Labor Trucking		3 00		
	1 hr. Rodgers Trailer		3 00		
			258 97		

TOWN OF LEXINGTON—DEPT. OF PUBLIC WORKS

SEWER DIVISION

DATE.....


NO.

The undersigned applies for the construction of a particular sewer connecting No.....
 Street and hereby agrees to comply with the Rules and Regulations governing the construction and use of Particular
 Sewers, as now or at any future time established by the Board of Selectmen.

Am't of estimate \$.....

Am't Paid \$.....

..... Owner

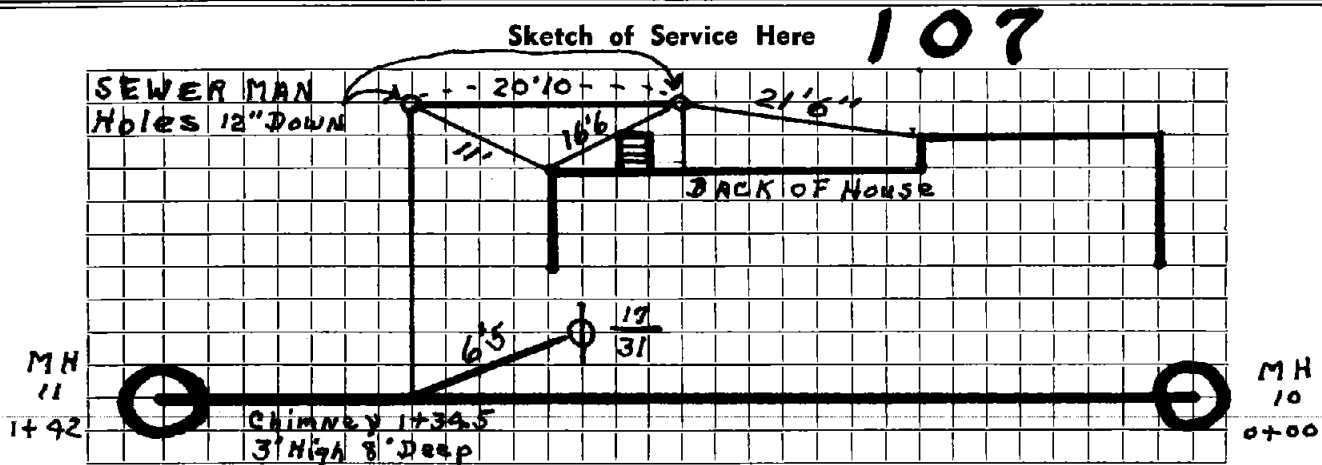

Connection made in..... Street.

Work completed.....19..

Remarks: