

Name

Service No.

Address # 111 Cedar St.

Location

Kind of Pipe

Size

Size of Main

Repair—Renewal—New Service

Location

Date

Material

Amount

Total

Date

Amount

8-8-57

47' 6" Transite

2 6"-1 1/4" Transite Bend

1 6" Clay Elbow

18' 6" Transite

1 6"-1 1/4" Transite Bend

Labor

TOWN OF LEXINGTON—DEPT. OF PUBLIC WORKS

SEWER DIVISION

DATE .....

NO. ....


The undersigned applies for the construction of a particular sewer connecting No. ....  
Street and hereby agrees to comply with the Rules and Regulations governing the construction and use of Particular  
Sewers, as now or at any future time established by the Board of Selectmen.

Am't of estimate \$.....

Am't Paid \$.....

..... Owner

Sketch of Service Here

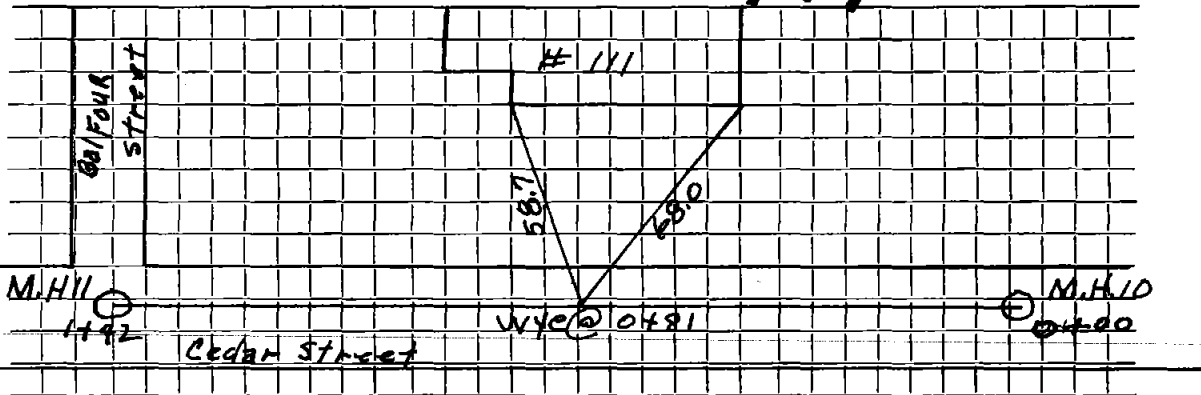

Connection made in ..... Street.

Work completed ..... 19..

Remarks: