

Name

Service No.

Address * 117 Cedar St.

Location

Kind of Pipe

Size

Size of Main

Repair—Renewal—New Service

Location

Date	Material	Amount	Total	Date		Amount
11-27-57	114' 6" Transite					
	Labor					
				9-20-96	Blockage in Main 165' up From Easement M.H.	

TOWN OF LEXINGTON—DEPT. OF PUBLIC WORKS
SEWER DIVISION

DATE

NO.


The undersigned applies for the construction of a particular sewer connecting No.
Street and hereby agrees to comply with the Rules and Regulations governing the construction and use of Particular
Sewers, as now or at any future time established by the Board of Selectmen.

Am't of estimate \$.....

Am't Paid \$.....

..... Owner

Sketch of Service Here **117**

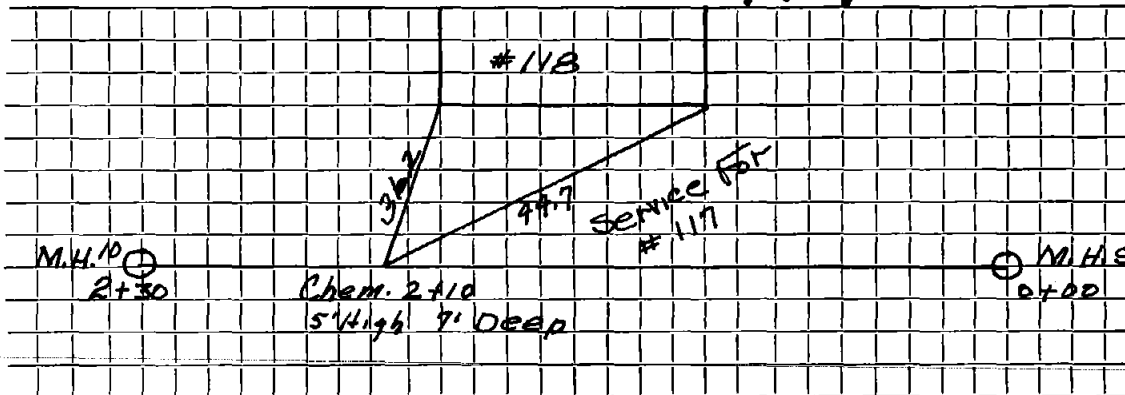

Connection made in Street.

Work completed 19..

Remarks:

