

Name ~~Leslie~~ Ghorbani

Service No.

Address 118 Cedar Street

Location

Kind of Pipe

Size

Size of Main

~~Repair~~ ~~Renewal~~ ~~New Service~~ Valeri #4446

Location

Date		Material	Amount	Total	Date	Amount
10/29/87	100'	6" PVC				
	4.6'	4" PVC				
	2	45° Sweeps				
	1	22 Sweep				
	1	22 Bend				
	1	90° Elbow				
	1	6 x 4 Wye				
	1	6 x 6 Fernco				
	1	3 x 4 Fernco				
	1	4 x 6 Fernco				
	5'	4" Cast Iron				
					12.3.91	Solids 170 to 180' up from M.H. #2660
					5.27.99	Grass 165' up from M.H. #2660


DATE _____

TOWN OF LEXINGTON — BOARD OF PUBLIC WORKS

SEWER DIVISION

Sketch of Service Here

118

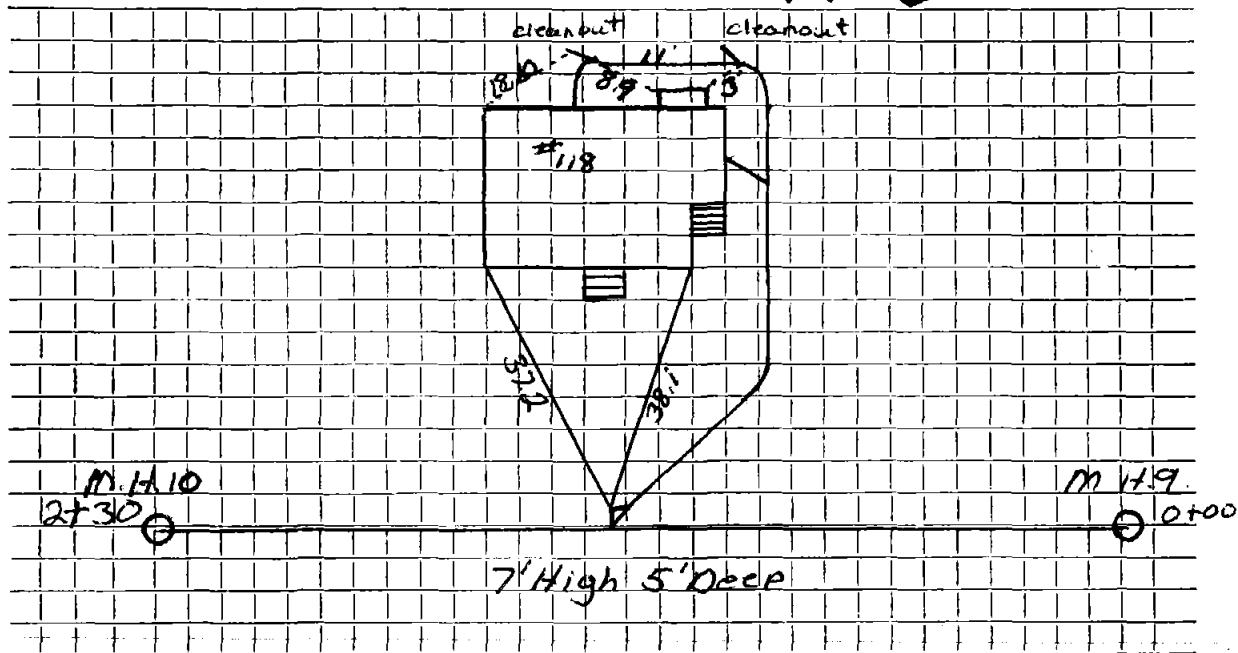

Connection made in Street. Work completed

Remarks:

.....

.....