

Name Albert DeAngelis

Service No. 21

Address # ¹²⁶ ~~124~~ Cedar St.

Changed per Eng. 3-5-78

Location

Kind of Pipe

Size

Size of Main

~~Repair/Replacement~~ New Service

Valeri #611 *WO# 4411*

Location

JAN 22 1968

Date	Material	Amount	Total	Date	Amount
6-8-67	22' 6" Transite pipe			4-8-67	125 00
	10' 4" Cast Iron pipe			4-4-68	71 87
					196 87
4/26/67	Labor	100 48			
	10% O.H.	10 05	110 52		
	15' 6" Transite pipe @ .88		13 20		
	1 Boag Cement		1 55		
	1 Load Stone		13 20		
	2 Loads Gravel @ 9.90		19 80		
	1 8 x 6 Saddle		5 50		
	4 Hrs. Trucking @ 3.00		12 00		
	2 labor Hrs. Shovel @ 6.50		13 00		
	1hr Dozer		4 00		
			196 87		

HP-6411

TOWN OF LEXINGTON—DEPT. OF PUBLIC WORKS

SEWER DIVISION

DATE


NO.

The undersigned applies for the construction of a particular sewer connecting No. Street and hereby agrees to comply with the Rules and Regulations governing the construction and use of Particular Sewers, as now or at any future time established by the Board of Selectmen.

Am't of estimate \$.....

Am't Paid \$.....

..... Owner

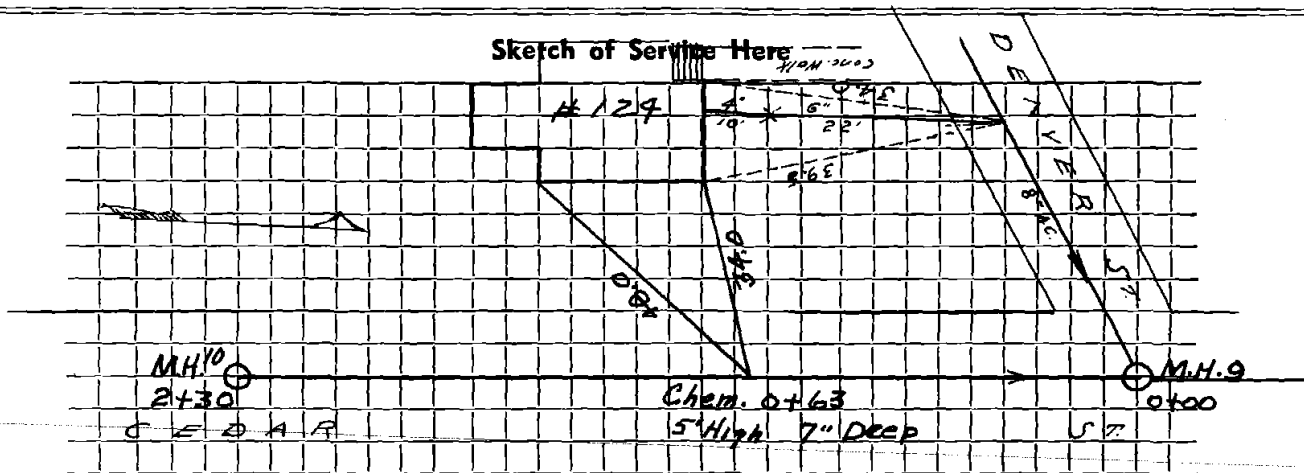

Connection made in Street.

Work completed 19..

Remarks: