

Name Frederick D. Smith

Service No. 137

Address #129 Cedar St.

Location

Kind of Pipe

Size

Size of Main

~~1256-1256-1256~~ New Service

Location *Cam 8-22-60*

Date	Material	Amount	Total	Date	Amount
8-1-60	Labor	58 41		<i>7-21-60</i>	<i>Deposit 300 00</i>
	10% O.H.	<u>5 84</u>	64 25	<i>8-22-60</i>	<i>Retard 124 15</i>
	70' 6" Transite pipe @78		54 60		<i>175 85</i>
	1 11 1/4° Transite Bend		5 10		
	1 90° Transite Elbow		5 40		
	18 x 3 Patch		18 00		
	3 Hrs Town Shovel @6.50		19 50		
	2 Hrs Trucking @3.00		6 00		
	1 Hr Trojan Loader @3.00		<u>3 00</u>		
			175 85		
	Labor				

TOWN OF LEXINGTON—DEPT. OF PUBLIC WORKS
SEWER DIVISION

DATE

NO.

The undersigned applies for the construction of a particular sewer connecting No.
 Street and hereby agrees to comply with the Rules and Regulations governing the construction and use of Particular
 Sewers, as now or at any future time established by the Board of Selectmen.


Am't of estimate \$.

Am't Paid \$.

..... Owner

Sketch of Service Here

129

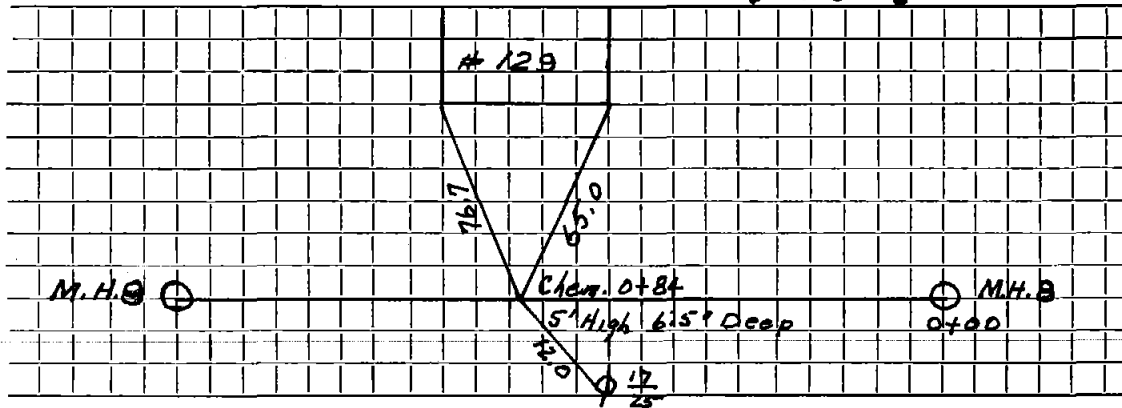

Connection made in Street.

Work completed 19..

Remarks: