

Name

Service No.

Address 132 Cedar Street

Lots #38,39,40,41

Location

Kind of Pipe

Size

Size of Main

Repair—Renewal—New Service

Location


Date	Material	Amount	Total	Date	Amount
1965	23 1/2" 6" Transite pipe @6.00		141.00		
				1965	
				23.6 6" Transite	

DATE _____

TOWN OF LEXINGTON — BOARD OF PUBLIC WORKS

SEWER DIVISION

Sketch of Service Here

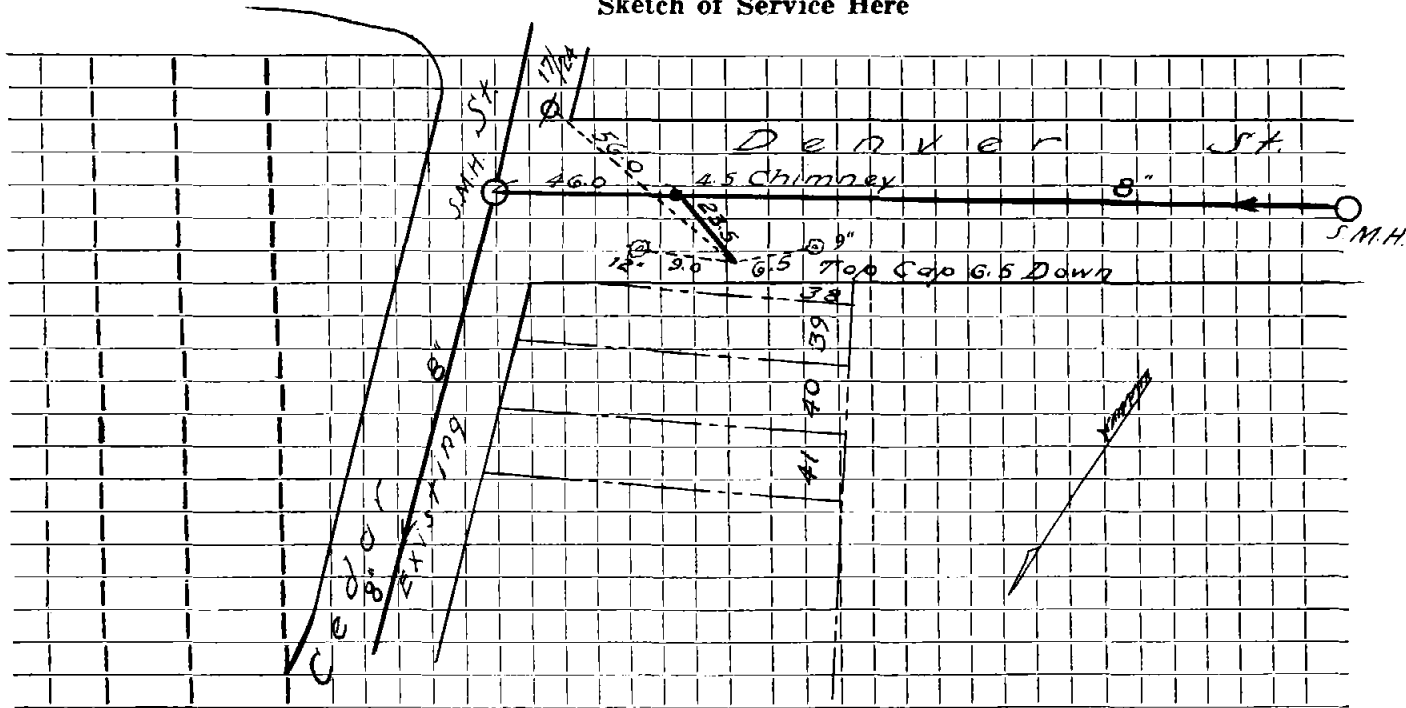

Connection made in Street. Work completed

Remarks:

.....

.....