

Name Griffith N. Buttrick

Service No. 94

Address #135 Cedar St.

Location

Kind of Pipe

Size

Size of Main

Repair—Renewal—New Service Valeri #732 W.O.# 5243

Location MAR 18 1968

Date	Material	Amount	Total	Date	Amount
8-18-67	132' 6" Transite pipe			8-4-67	150 00
				4-22-68	150 00
8-7-67	Labor 129.12				
8-16-67	Labor 10.98				
"	Labor 13.79	153 89			
	10% O.H.	15 39	169 28		
	18' 6" Transitepipe @ .88		15 84		
	$\frac{1}{2}$ bag cement		78		
	1 ton cold patch		5 00		
	4 hrs. trucking @ 3.00		12 00		
	5 hrs. shovel @ 6.50		32 50		
	$1\frac{1}{2}$ hrs. loader @ 4.00		6 00		
	$\frac{1}{2}$ hr. compressor @ 5.00		2 50		
	$\frac{1}{2}$ hr. roller @ 3.00		1 50		
			245 40		

TOWN OF LEXINGTON—DEPT. OF PUBLIC WORKS

SEWER DIVISION


DATE

NO.

The undersigned applies for the construction of a particular sewer connecting No. Street and hereby agrees to comply with the Rules and Regulations governing the construction and use of Particular Sewers, as now or at any future time established by the Board of Selectmen.

Am't of estimate \$.....

Am't Paid \$.....

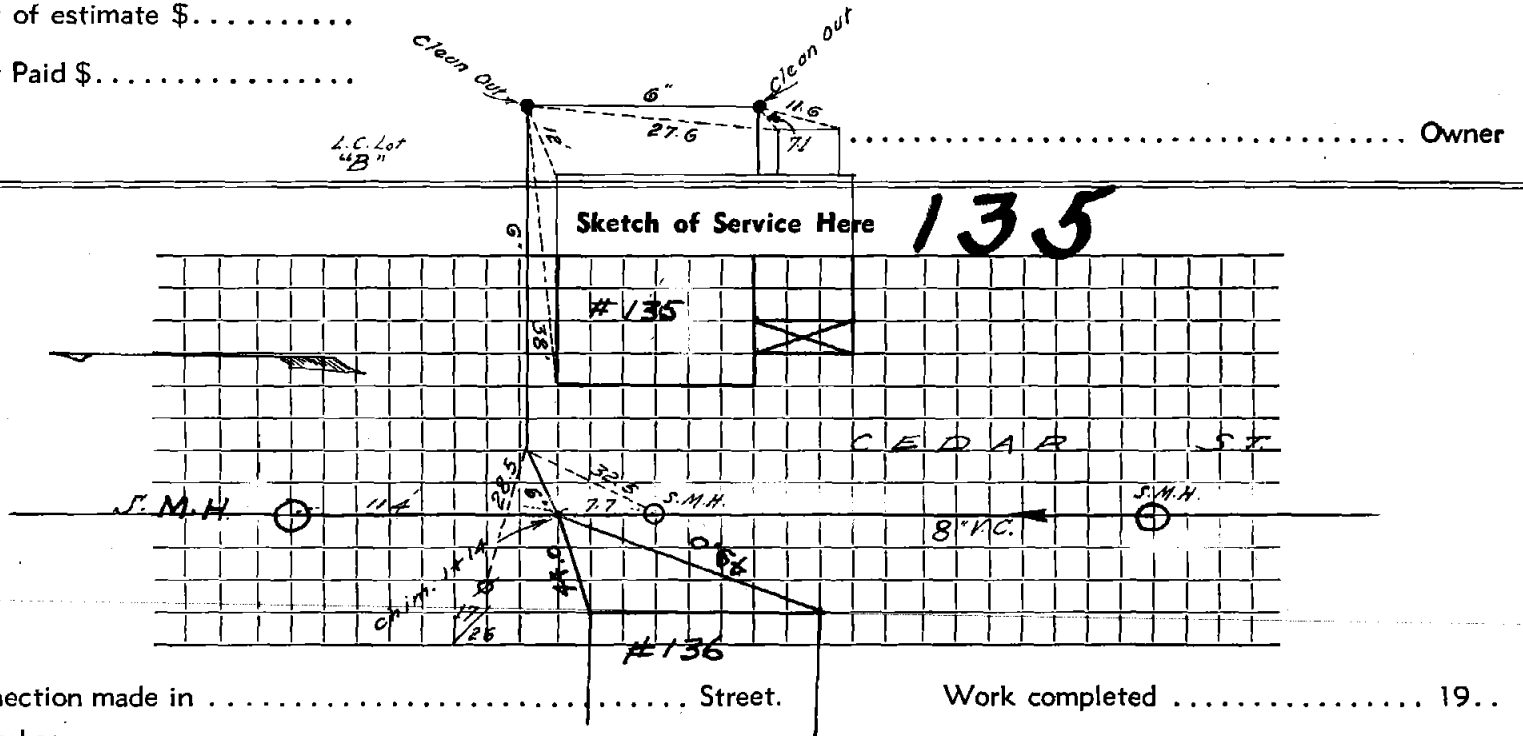

Remarks: