

Name John C. Nelson

Service No. 136

Address 136 Cedar Street

Location

Kind of Pipe W.O. #9132

Size

Size of Main

Repair—Renewal—New Service J. Grant - Permit #78


Location DEC 28 1964

Date	Material	Amount	Total	Date	Amount
9-21-64	Labor	60 28		8-19-64	100 00
	10% O.H.	6 03	66 31	8-20-65	9 11
	20' 6" Transite Pipe @.82		16 40		109 11
	12 X 3 Patch		12 00		
	1 90° Elbow		4 90		
	1 Hr. Town Shovel		6 50		
	1 Hr. Town Trucking @3.00		3 00		
			109 11		
9-24-64	30' 6" Transite Pipe				

DATE _____

TOWN OF LEXINGTON — BOARD OF PUBLIC WORKS
SEWER DIVISION

Sketch of Service Here **136**

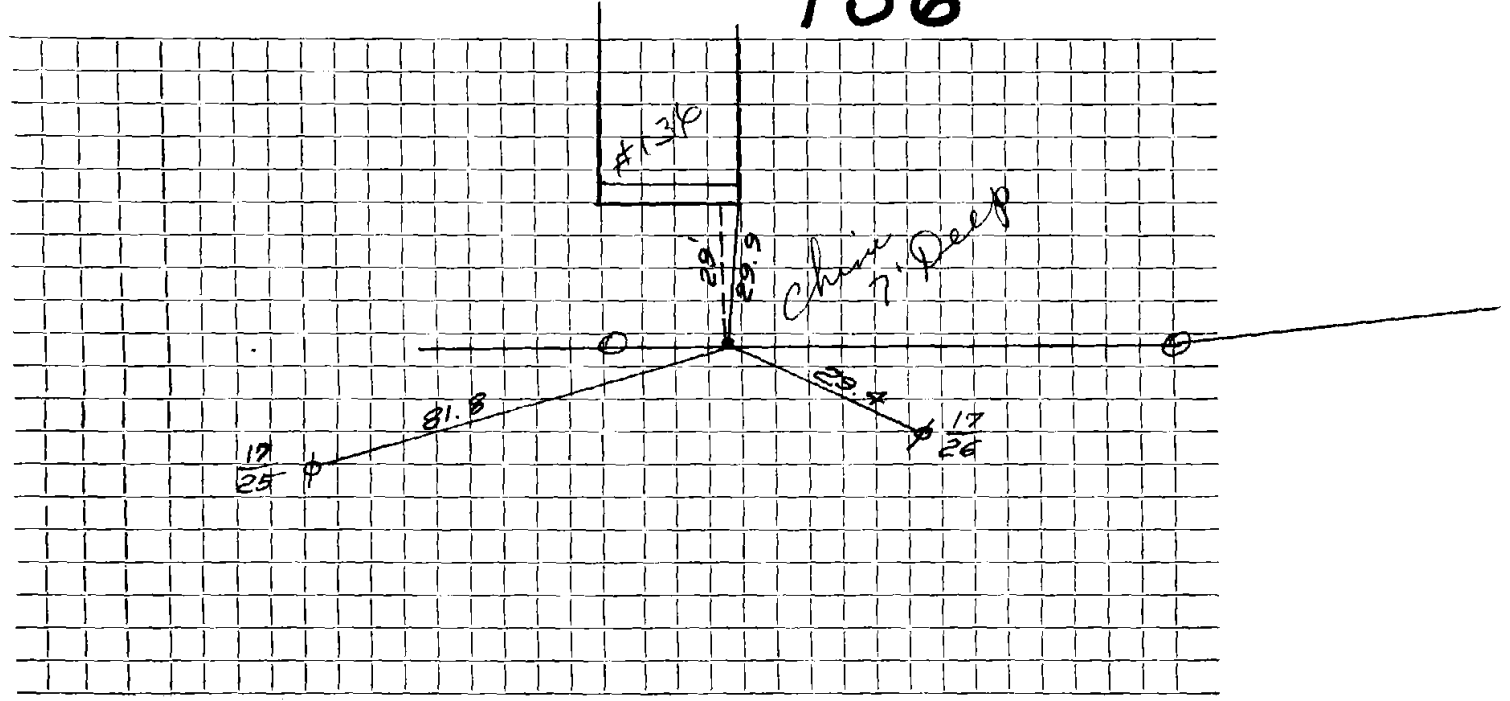

Connection made in Street. Work completed

Remarks:
.....
.....