




DATE 4/10/91

TOWN OF LEXINGTON — BOARD OF PUBLIC WORKS

SEWER DIVISION

Sketch of Service Here **147**

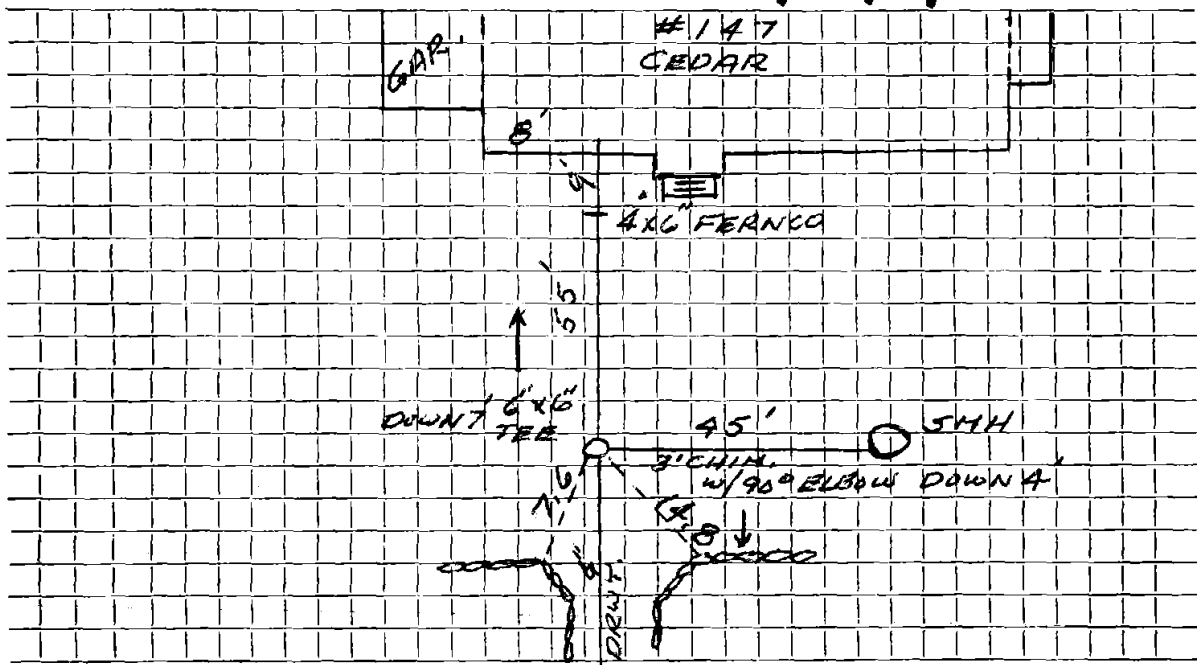

Connection made in CEDAR Street. #148 Work completed .....

Remarks: TWO SERV.'S USING SAME CHIM. .....