



TOWN OF LEXINGTON—DEPT. OF PUBLIC WORKS

SEWER DIVISION

DATE .....

NO. ....


The undersigned applies for the construction of a particular sewer connecting No. .... Street and hereby agrees to comply with the Rules and Regulations governing the construction and use of Particular Sewers, as now or at any future time established by the Board of Selectmen.

Am't of estimate \$.....

Am't Paid \$.....

..... Owner

Sketch of Service Here **153**

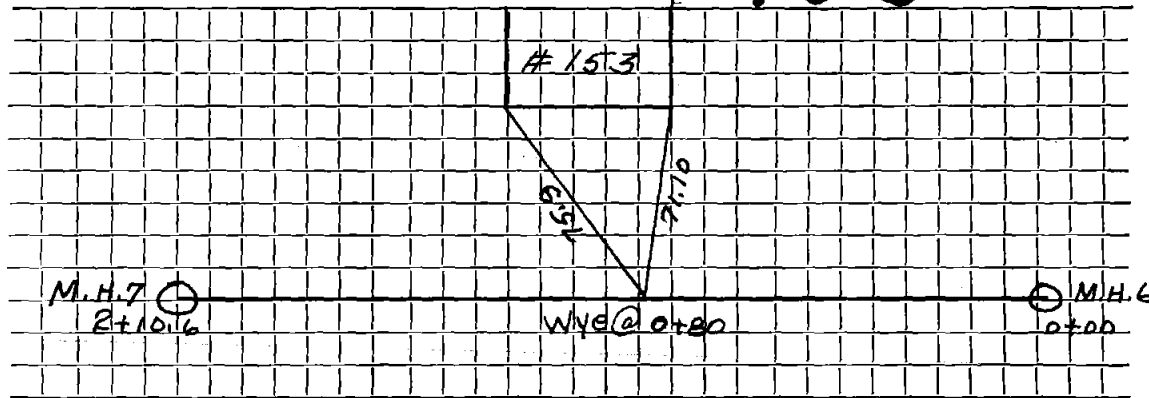

Connection made in ..... Street.

Work completed ..... 19..

Remarks: