

Name *John Sirois*

Service No. 139

Address # *154 Cedar St.*

Location

Kind of Pipe

Size

Size of Main

Repair—Renewal—New Service ✓ *DeFlice Bros, # 2363 W.O. # 1395*

Location

FEB 10 1975

Date	Material	Amount	Total	Date	Amount
				10/17 73	
11-13-73	30' - 6" ACP			1½	hr. Town Shovel @ 6.50 \$9.75
	10' - 4" CI			1	hr. Loader 4.00
10/17/73	Labor	\$75.64		3	hr. Trucking @ 3.00 9.00
	10% O.H.	7.56	\$83.20		
10	6" Transite pipe @ .99		9.90		
1	6x8 CI Saddle		5.50		Total \$139.65
1	2x6 Nipple w/plug		1.04	10-16-73	Deposit 140.00
1	1x6 Nipple w/plug		.65	2-10-75	Retund 20.35
1	6x6 Nipple		1.55		139.65
1	90° Elbow		5.65		
	Labor				
2	yard gravel @ 2.19		4.38		
1	hr. Compressor @ 5.00		5.00		

TOWN OF LEXINGTON—DEPT. OF PUBLIC WORKS
SEWER DIVISION

DATE

NO.


The undersigned applies for the construction of a particular sewer connecting No. Street and hereby agrees to comply with the Rules and Regulations governing the construction and use of Particular Sewers, as now or at any future time established by the Board of Selectmen.

Am't of estimate \$.....

Am't Paid \$.....

..... Owner

Sketch of Service Here **154**

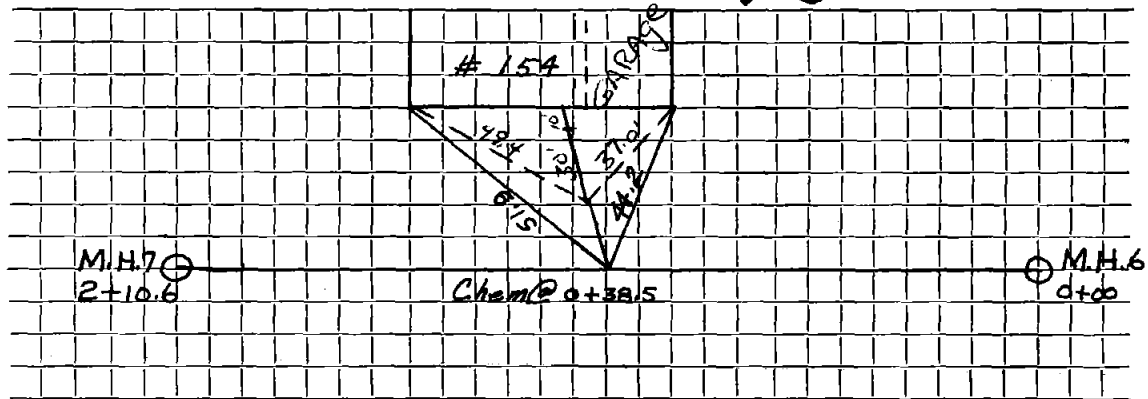

Connection made in Street.

Work completed 19..

Remarks:

