


DATE _____

TOWN OF LEXINGTON — BOARD OF PUBLIC WORKS

SEWER DIVISION

Sketch of Service Here

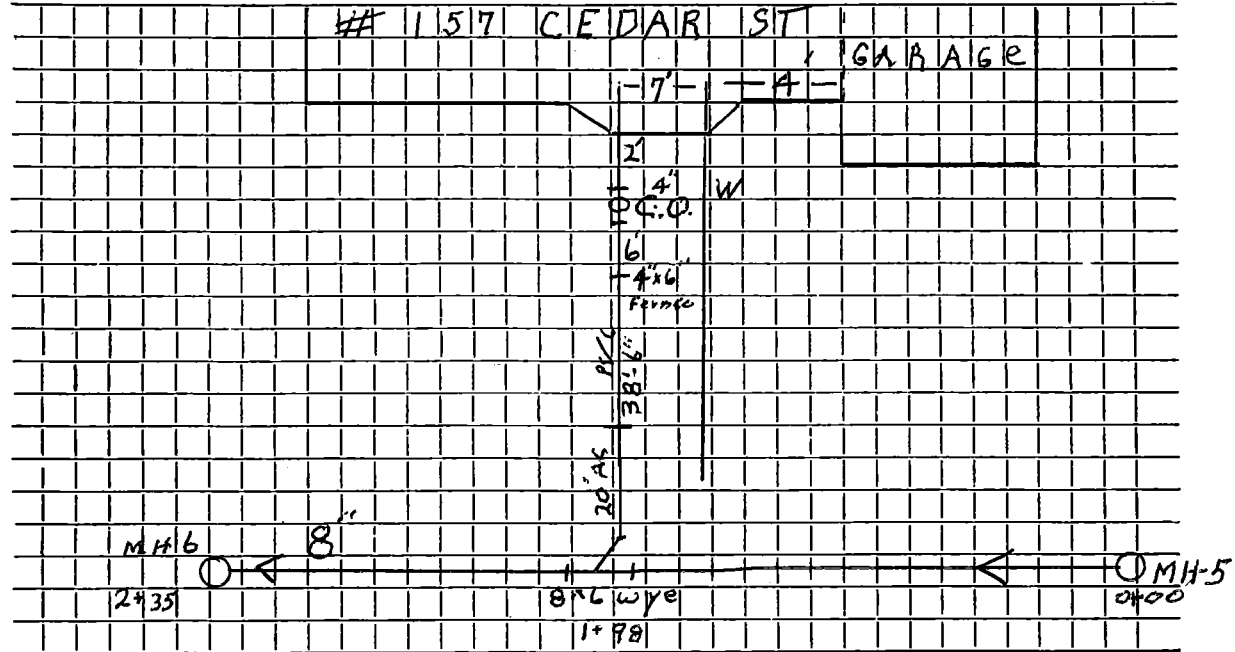

Connection made in Street.

Work completed 8-6-10 J. M. Laughlin.....

Remarks:
.....
.....