

Name Mary OramService No. 100Address # 160 Cedar St.

Location

Kind of Pipe

Size

Size of Main

~~Repair~~ ~~Renewal~~ New Service

Location

Com. 8-1-60

Date	Material	Amount	Total	Date	Amount	
7-1-60	Labor	91.77		6-10-60	Deposit	250.00
	10% O.H.	9.18	100.95	8-1-60	Refund	35.41
	66' 6" Transite pipe @78		51.48			214.59
	2 22 $\frac{1}{2}$ " Transite Bends @6.21		12.42			
	1 11 $\frac{1}{4}$ " Transite Elbow		2.24			
	3 Hrs Town Shovel @6.50		19.50	5-18-04		
	3 Hrs Trucking @3.00		9.00		RESPOND AND MEASURE	
	1 Hr Trailer @3.00		3.00			
	16 x 3 Patch		16.00	6-14-04	SERVICE REPAIRED TO MAIN	
			214.59		14'-6" PVC	
	Labor				6" -90° ELBOW	
					2- 6x6 FERRUCOS	

TOWN OF LEXINGTON—DEPT. OF PUBLIC WORKS
SEWER DIVISION

DATE

NO.


The undersigned applies for the construction of a particular sewer connecting No. Street and hereby agrees to comply with the Rules and Regulations governing the construction and use of Particular Sewers, as now or at any future time established by the Board of Selectmen.

Am't of estimate \$.....

Am't Paid \$.....

..... Owner

Sketch of Service Here **160**

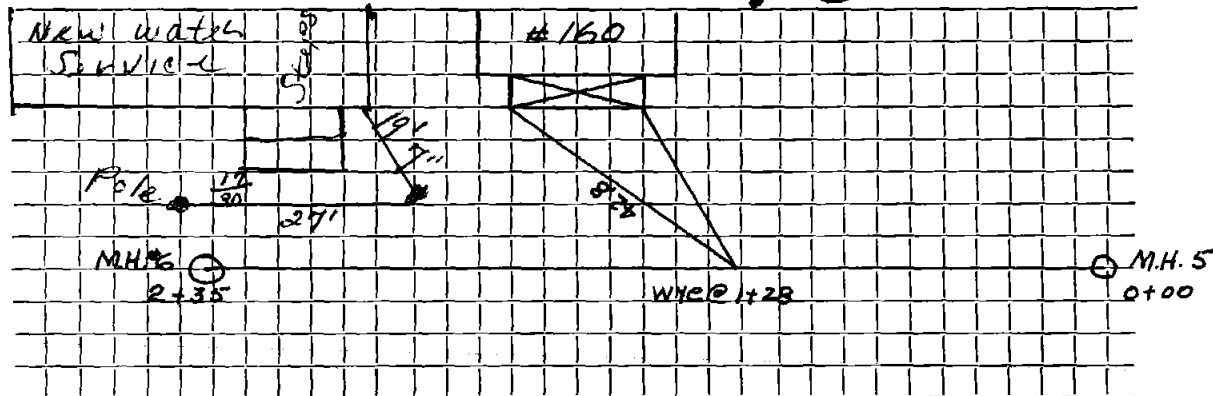

Connection made in Street.

Work completed 19..

Remarks: