

Name

Service No.

Address

163 Cedar St

Location

Kind of Pipe

Size

Size of Main

Repair—Renewal—New Service

Location

Date

Material

Amount

Total

Date

Amount

4.11.05

30' - 6" PVC

10' - 4" PVC

4x6 PVC to PVC FERRULO

6x6 PVC to AC FERRULO

7.3.58


45' 6" TRANSITE

1 - 6" Elbow (Clay)

DATE \_\_\_\_\_

**TOWN OF LEXINGTON — BOARD OF PUBLIC WORKS**  
**SEWER DIVISION**

Sketch of Service Here

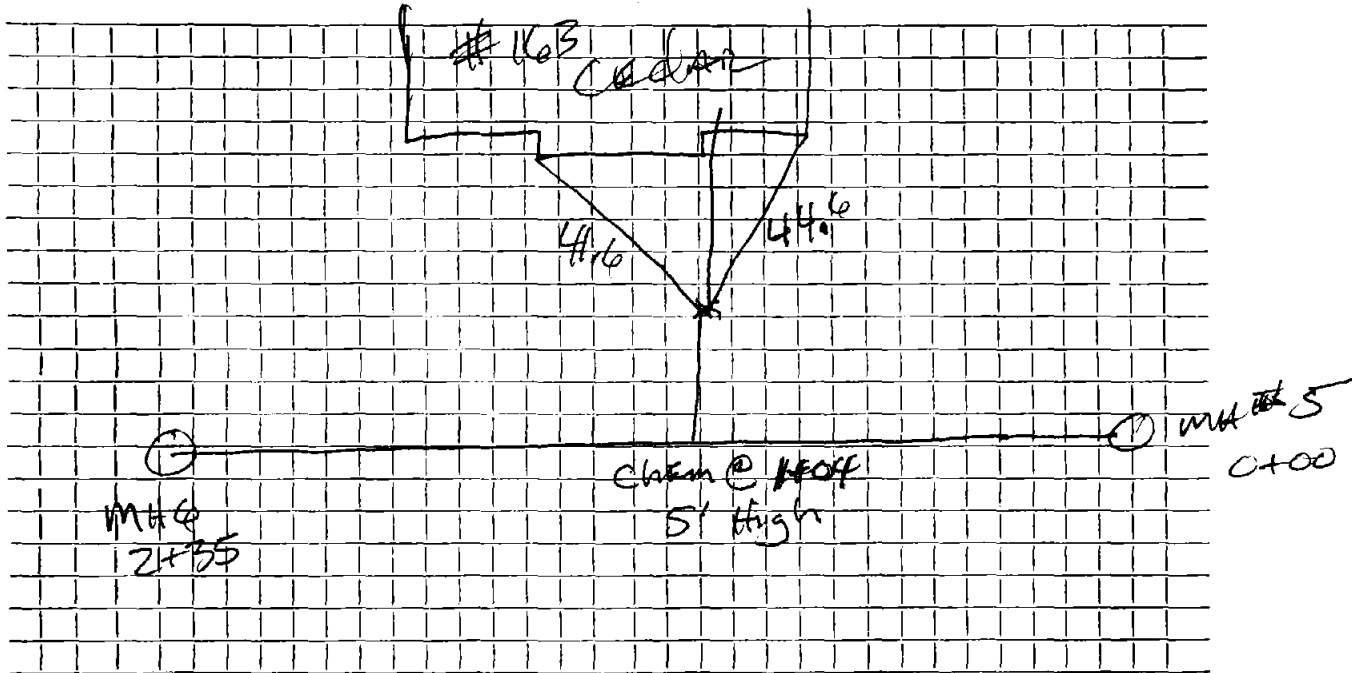

Connection made in ..... Street. Work completed .....

Remarks: .....

.....  
.....