

Name *Donald L. Price*

Service No.

Address # *177 Cedar St.*

Location

Kind of Pipe

Size

Size of Main

~~Repair-Renewal~~ *Repair-Renewal* - New Service W.O. #9009 - Cont. Lexington Sewerage

#1726

Location **NOV 23 1970**

Date	Material	Amount	Total	Date	Amount
9/29/70	Labor	88 35		<i>9-22-70</i>	<i>Deposit</i> 345 00
10/13/70	Labor	11 10	99 45	<i>11-23-70</i>	<i>Refund</i> 59 55
	10% O.H.		9 95		185 45
	20' 6" Transite pipe .90		18 00		
	1 6" Saddle		5 50		
	1 6" Nipple		1 20		
	$\frac{1}{4}$ 90° Ell Bag cement 1.80		5 65 45		
	$\frac{1}{4}$ Ton cold patch 6.00		1 50		
	2 Ton Hot top 6.00		12 00		
	1 $\frac{1}{2}$ Hrs. Trucking 3.00		4 50		
	$\frac{1}{2}$ " " 1.50		75		
	$\frac{3}{4}$ " Shovel 6.50		19 50		
	1 $\frac{1}{2}$ " Loader 4.00		2 00		
	1 " Labor Compressor		5 00		
			185 45		
<i>9/30/70</i>	93' 6" Transite pipe				
	10' 4" Cast Iron pipe				

TOWN OF LEXINGTON—DEPT. OF PUBLIC WORKS

SEWER DIVISION

DATE


NO.

The undersigned applies for the construction of a particular sewer connecting No. Street and hereby agrees to comply with the Rules and Regulations governing the construction and use of Particular Sewers, as now or at any future time established by the Board of Selectmen.

Am't of estimate \$.....

Am't Paid \$.....

..... Owner

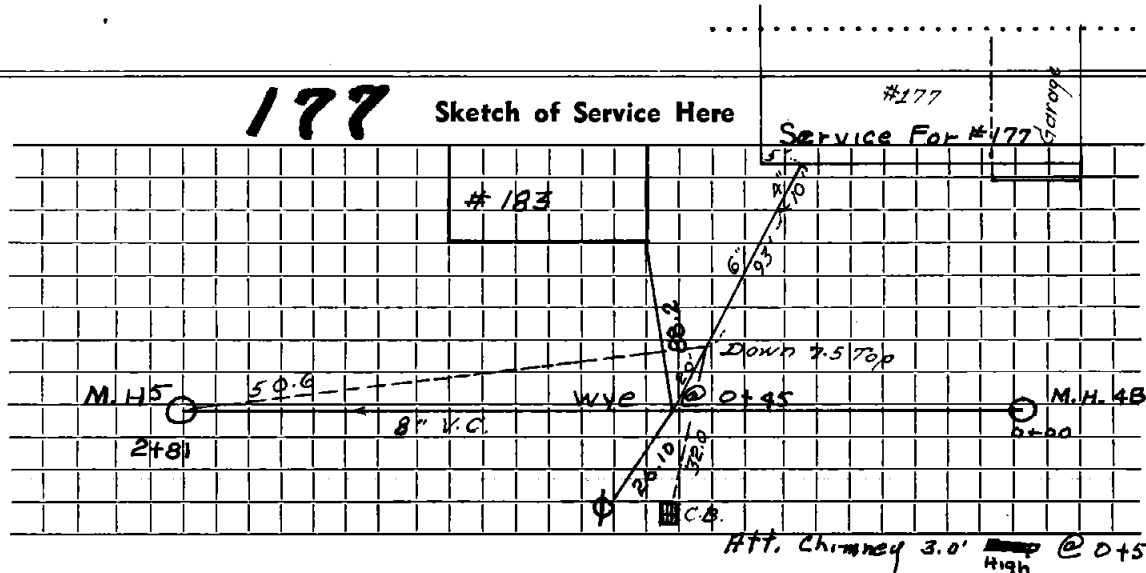

Connection made in Street.

Work completed 19..

Remarks: