

Name Harris Traiger

Service No. 104

Address 183 Cedar Street

Location

Kind of Pipe

Size

Size of Main

~~Repair/Remove~~ New Service Eagle #3476 W.O.#921

Location JAN 21 1980

Date	Material	Amount	Total	Date	Amount
11-30-79	Labor	158.58		11-30-79	300.00
	10% O.H.	15.86	174.44	2-20-80	22.24
20'	6" Transite pipe @1.91		38.20		322.24
2	ton Sand @2.99		5.98		
1	6" Cap		4.60		
3	hrs. Trucking		9.00		
4	hrs. Backhoe		26.00		
	Hot Top 6' x 16'		64.02		
			322.24		
12-3-79	59' 6" Transite pipe				
	10' 4" Cast Iron pipe				

Deposit Paid

TOWN OF LEXINGTON—DEPT. OF PUBLIC WORKS

SEWER DIVISION

DATE

NO.


The undersigned applies for the construction of a particular sewer connecting No.
Street and hereby agrees to comply with the Rules and Regulations governing the construction and use of Particular
Sewers, as now or at any future time established by the Board of Selectmen.

Am't of estimate \$.

Am't Paid \$.

..... Owner

Sketch of Service Here

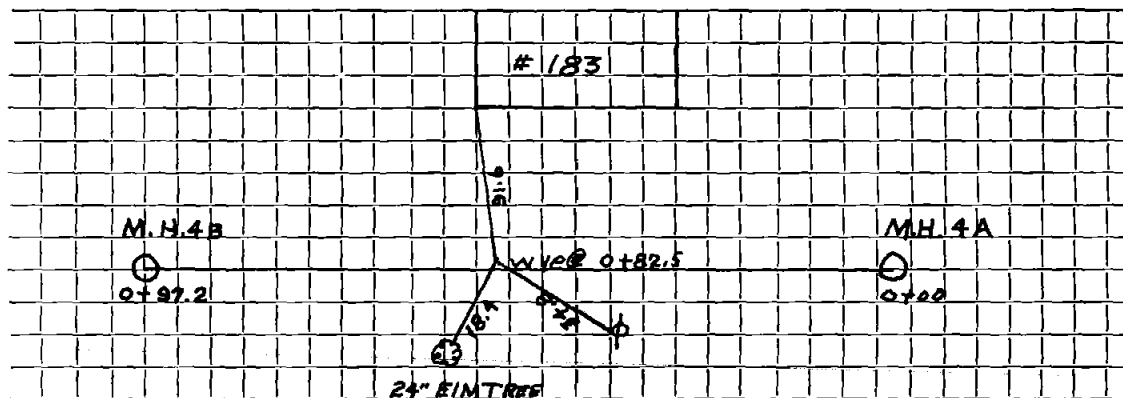

Connection made in CEDRAR ST. Street.

Work completed 19..


Remarks: SERVICE CABLE DRAINED BACKWARDS

DATE _____

TOWN OF LEXINGTON — BOARD OF PUBLIC WORKS
SEWER DIVISION

Sketch of Service Here

183

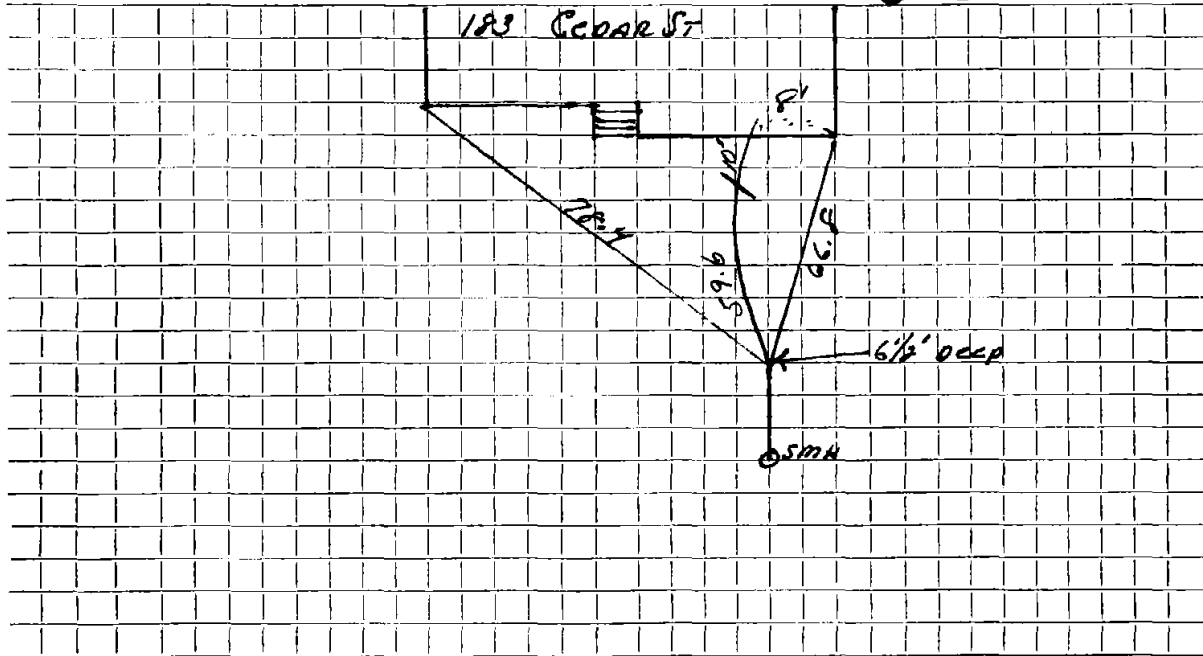

Connection made in Street. Work completed

Remarks:

.....
.....