




DATE \_\_\_\_\_

# TOWN OF LEXINGTON — BOARD OF PUBLIC WORKS

## SEWER DIVISION

Sketch of Service Here

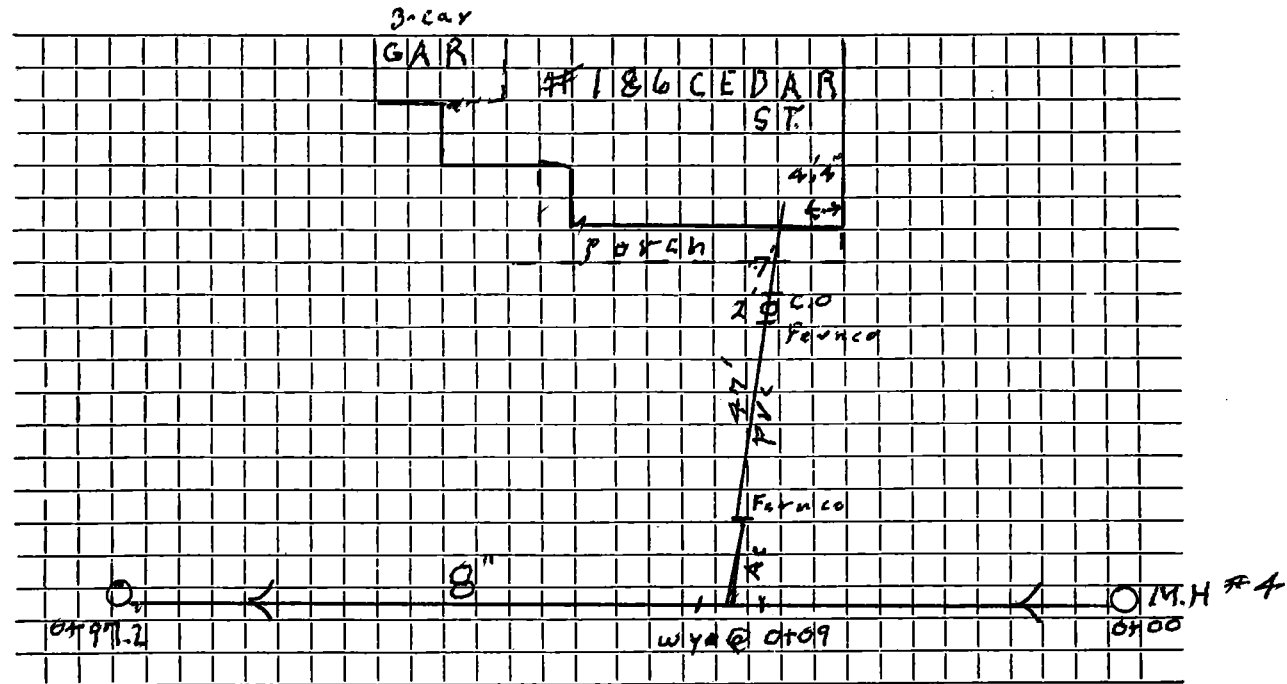

Connection made in ..... Street.

Work completed 8/17/11 - J. M. Laughlin...

Remarks: .....  
.....  
.....