

Name Richard Rogers

Service No. 98

Address #187 Cedar St.

Location

Kind of Pipe

Size

Size of Main

~~Repair~~ ~~Renewal~~ New Service

Watt 8151

Location Comm 10-28-63

Date	Material	Amount	Total	Date		Amount
8-27-63	Labor	93.43		9-9-63	Deposit	250 00
	10% O.H.	9.34	102.77	10-28-63	Refund	54 11
	41' 6" Transite pipe @.82		33.62			195 89
	10 x 3 Patch		10.00			
	3 yds. Loam @3.00		9.00			
	5 hrs. Town Shovel @6.50		34.50			
	2 hrs. Trucking @3.00		6.00			
			195.89			
	Labor					

TOWN OF LEXINGTON—DEPT. OF PUBLIC WORKS

SEWER DIVISION

DATE

NO.


The undersigned applies for the construction of a particular sewer connecting No. Street and hereby agrees to comply with the Rules and Regulations governing the construction and use of Particular Sewers, as now or at any future time established by the Board of Selectmen.

Am't of estimate \$.....

Am't Paid \$.....

..... Owner

Sketch of Service Here **187**

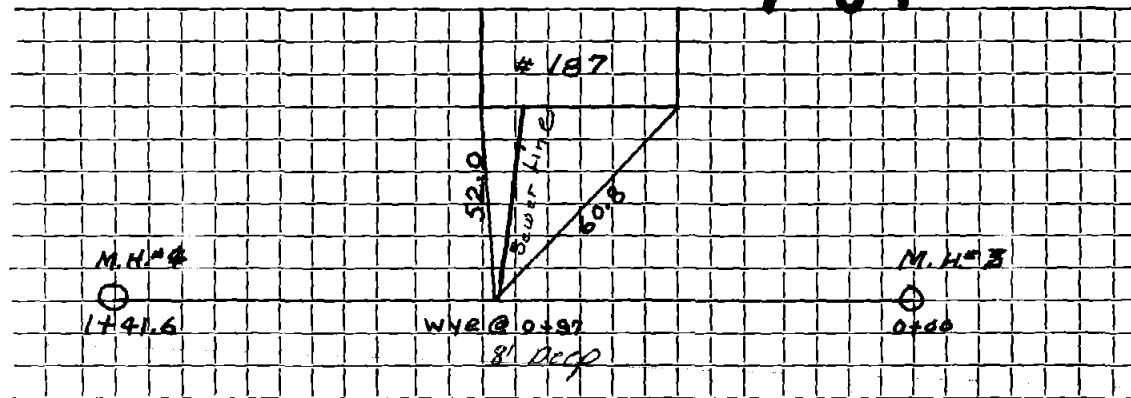

Connection made in Street.

Work completed 19..

Remarks: