

Name Edward B. Lloyd

Service No. 208

Address 192 Cedar Street

Location

Kind of Pipe

Size

Size of Main

~~Repair Order~~ New Service W.O. #8358

Location MAR 23 1964


Date	Material	Amount	Total	Date	Amount
12-6-63	Labor	85.61			
12-9-63	"	35.53	121 14	12-2-63	300 00
	10% O.H.	12 11	133 25	3-23-64	22 37
92'	6" Transite Pipe @.82		75 44		377 63
1	1 1/4" Transite Elbow		2 35		
1	1 1/4" Transite Bend		4 09		
5	Hrs. Town Shovel @ 6.50		32 50		
4	Hrs. Trucking @3.00		12 00		
18	X 3 Patch		18 00		
			277 63		

DATE _____

TOWN OF LEXINGTON — BOARD OF PUBLIC WORKS
SEWER DIVISION

Sketch of Service Here

192

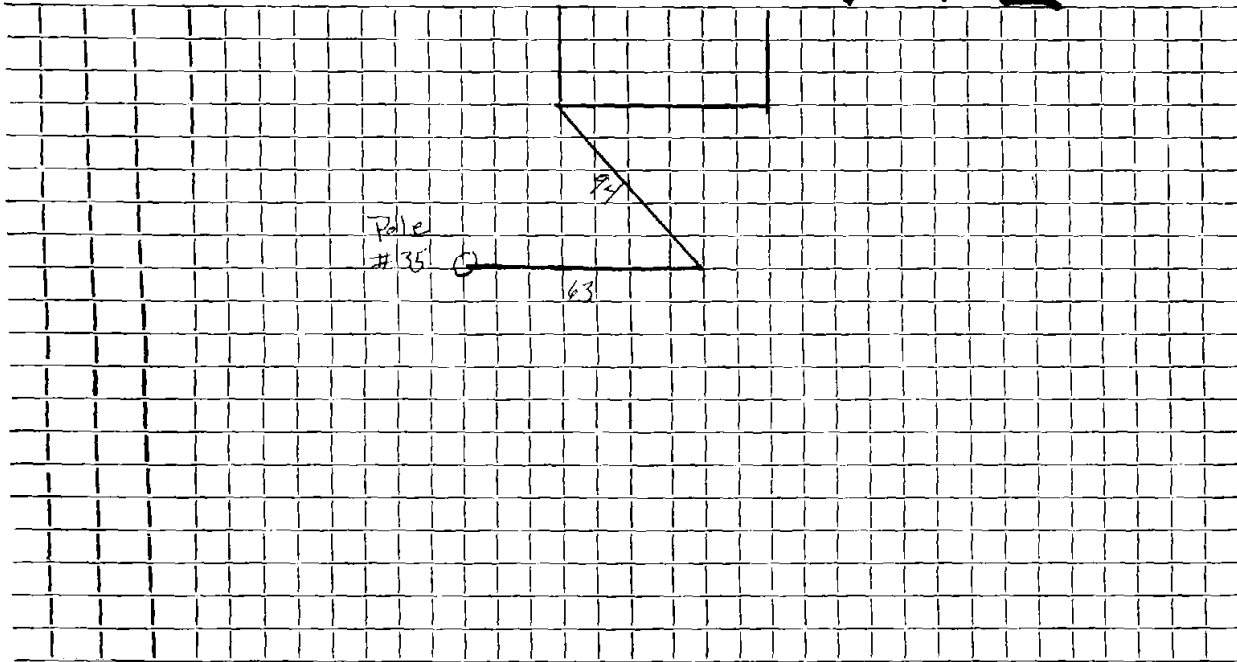

Connection made in Street. Work completed

Remarks:
.....
.....