

Name Clarence Pierce

Service No. 141

Address # 193 Cedar Street

Location

Kind of Pipe

Size

Size of Main

~~Repair~~ ~~Renewal~~ New ServiceLocation *Comm 12-58*

Date	Material	Amount	Total	Date	Amount
9/19/58	labor	29 72		8-21-58	<i>Deposit</i>
9/22/58	"	20 02		8-8-58	<i>Refund</i>
9/23/58	"	65 08			
			114 82		
	10% overhead		11 48		
			126 30		
	158' 6" transite pipe @ .70		110 60		
	2 6" 22 $\frac{1}{2}$ " bends @ 6.21		12 42		
	2 6" 11 $\frac{1}{4}$ " bends @ 5.10		10 20		
	1 6" clay elbow		1 88		
	1 bag cement		1 50		
	4 hrs. town shovel @ 6.50		26 00		
	4 hrs. trucking @ .75		3 00		
	Labor 5' patching		5 00		
			296 90		

**TOWN OF LEXINGTON—DEPT. OF PUBLIC WORKS
SEWER DIVISION**

DATE.....

NO.


The undersigned applies for the construction of a particular sewer connecting No.....
Street and hereby agrees to comply with the Rules and Regulations governing the construction and use of Particular
Sewers, as now or at any future time established by the Board of Selectmen.

Am't of estimate \$.....

Am't Paid \$.....

..... Owner

Sketch of Service Here **193** S.S. FOR #193

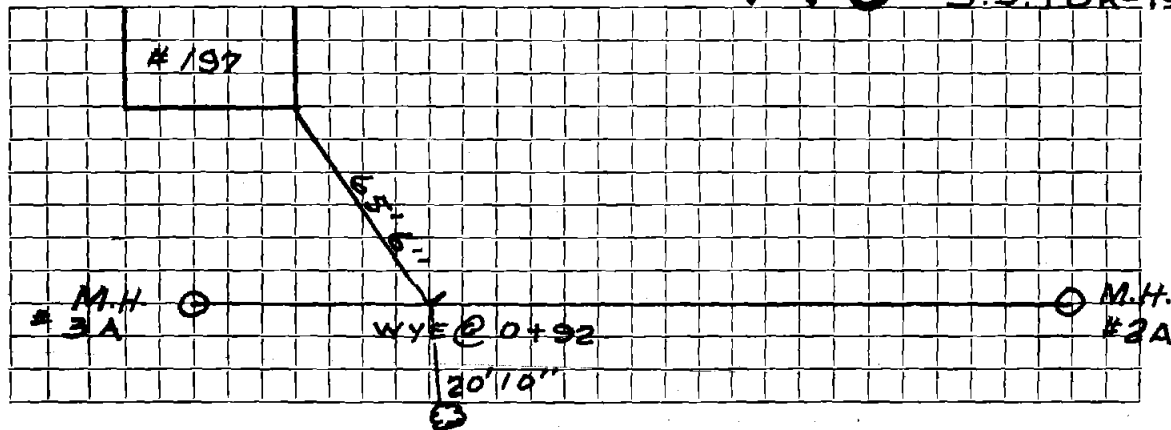

Connection made in..... Street.

Work completed.....19..

Remarks: