


TOWN OF LEXINGTON — BOARD OF PUBLIC WORKS
SEWER DIVISION

DATE 6/8/21

Sketch of Service Here

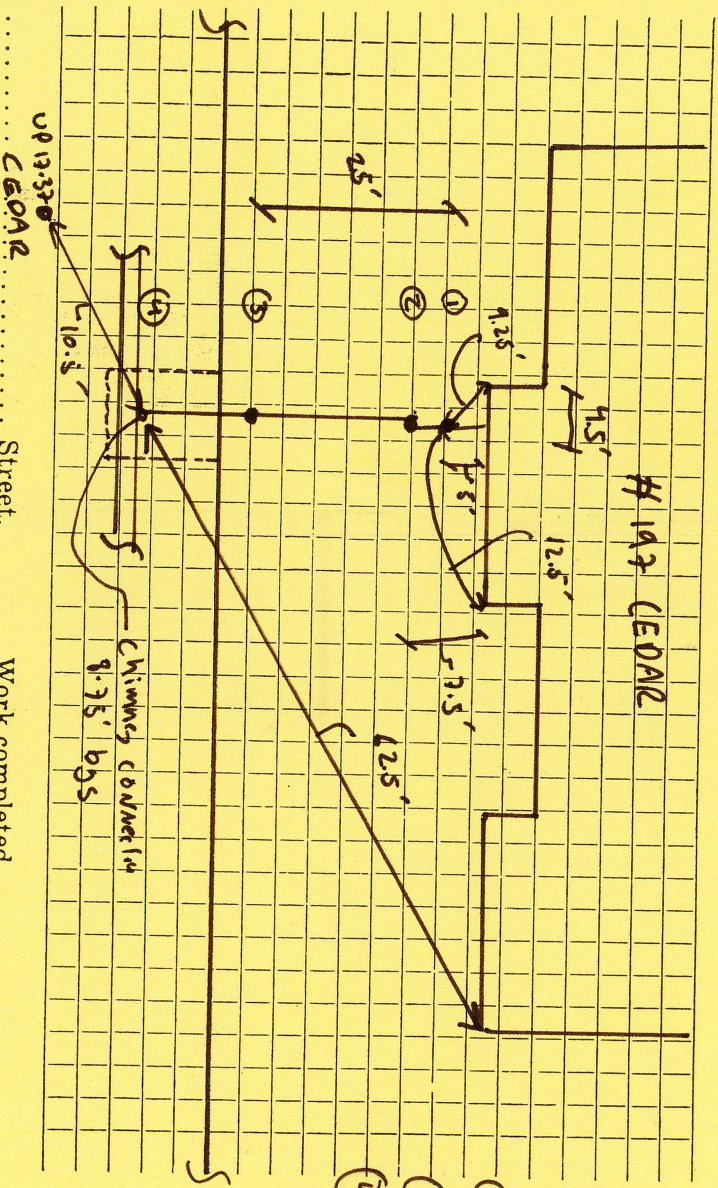

- ① 4" PVC
- ② 6" Clean out
- ③ 8" SUG 84 ROAD
- ④ Chimney, to town MAIN

Connection made in Street. Work completed

Remarks: X Chimney Details: SAADLE, 1' 6" PVC, 45° Bend (8.75' bgs).

Name Paul Plasse

Service No. 105

Address 197 Cedar Street

V02-9468

Location

Kind of Pipe

Size

Size of Main

~~REPAIR~~ ~~RENEWAL~~ - New Service

Location

Cedar St - 105

Date	Material	Amount	Total	Date	Amount
7-5-60	Labor	96 44		6-14-60	Deposit 300 00
7-8-60	"	9 19		8-1-60	Retard 67 29
	10% OH	10 56	116 19		232 21
77'	6" Transite pipe @78		60 06		
1	22 1/2° Transite bend		6 21		
2'	6" Clay pipe @435		87		
1	6" Clay Elbow		1 88		
	15 x 3 Patch		15 00		
4	Hrs Town Shovel @6.50		26 00		
2	Hrs Trucking @3.00		6 00		
			232 21		
	Labor				

TOWN OF LEXINGTON—DEPT. OF PUBLIC WORKS
SEWER DIVISION

DATE.....

NO.

The undersigned applies for the construction of a particular sewer connecting No.....
Street and hereby agrees to comply with the Rules and Regulations governing the construction and use of Particular
Sewers, as now or at any future time established by the Board of Selectmen.


Am't of estimate \$.....

Am't Paid \$.....

..... Owner

Sketch of Service Here

NO TELL ON WYE

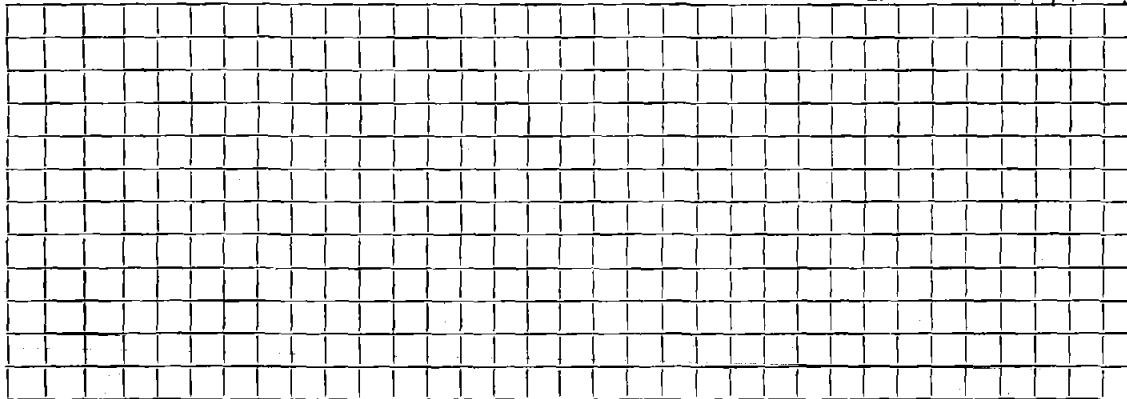

Connection made in..... Street.

Work completed.....19..

Remarks: