

Name Leonard Jellis

Service No. 277

Address # 87 Cedar St.

Location

Kind of Pipe

Size

Size of Main

Repair—Renewal—New Service

Location *Comm 5-8-61*

Date	Material	Amount	Total	Date	Amount
3-22-61	Labor 108.61			<i>12-1-61</i>	<i>Deposit 250.00</i>
3-23-61	" 8.14	116.75		<i>6-5-61</i>	<i>Paid 35.69</i>
	10% O.H.	11.68	128.43		<i>285.69</i>
	71' 6" Transite pipe @.78		55.38		
	1 6" Duplex Adapter		1.90		
	1 6" 90° Transite Elbow		5.40		
	7 3/4 ton Gravel @.85		6.58		
	34 x 3 Patch		34.00		
	6 hrs. Town Shovel @6.50		39.00		
	3 hrs. Trucking @3.00		9.00		
	2 hrs. Loader @3.00		6.00		
	<b>Labor</b>		<b>285.69</b>		

TOWN OF LEXINGTON—DEPT. OF PUBLIC WORKS  
**SEWER DIVISION**

DATE .....

NO. ....


The undersigned applies for the construction of a particular sewer connecting No. ....  
Street and hereby agrees to comply with the Rules and Regulations governing the construction and use of Particular  
Sewers, as now or at any future time established by the Board of Selectmen.

Am't of estimate \$.....

Am't Paid \$.....

..... Owner

Sketch of Service Here **87**

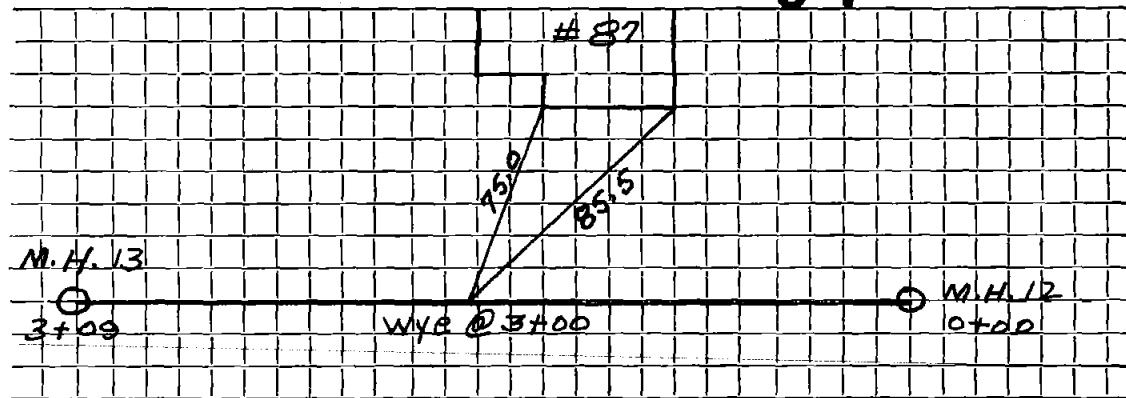

Connection made in ..... Street.

Work completed ..... 19..

Remarks: