


DATE _____

TOWN OF LEXINGTON — BOARD OF PUBLIC WORKS

SEWER DIVISION

Sketch of Service Here

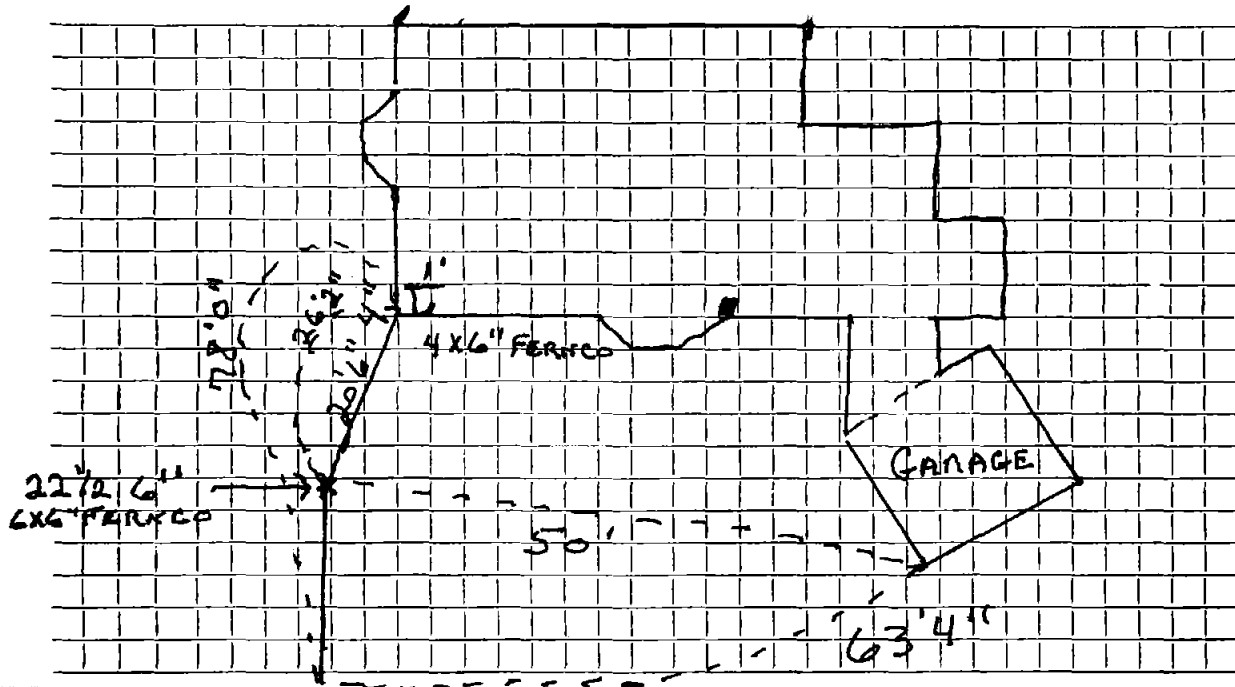

Connection made in Street. Work completed

Remarks: NEW PIPE 26' old PIPE 55' TOTAL 81'

INSTALLED BY J.M. McLAUGHLIN