

Name John E. Carlson

Service No. 97

Address # 97 Cedar St.

Location

Kind of Pipe

Size

Size of Main

~~XXXXXX~~ New Service

Location Comm 11-13-61

Date	Material	Amount	Total	Date	Amount
8/14/61	Labor	102.37		7-28-61	250 00
8/15/61	"	107.35		1-27-62	283 11
8/16/61	"	100.70			533 11
8/17/61	"	17.68			
8/18/61	"	14.22	342 33		
	10% O.H.		34 23		
			376 56		
	52 6" Transite Pipe @ .78		40 56		
	37 Sticks Dynamite @ .27		9 99		
	25 Blasting Caps @ .26		6 50		
	6 Hrs. Town Shovels @ 6.50		39 00		
	6 <del>hrs.</del> Hrs. Trucking @ 3.00		18 00		
	4 Hrs. Compressor @ 3.00		12 00		
	1 6" Transite Elbow 90°		5 40		
	1 11 1/4" Transite Bend		5 10	533.11	
	20 X 3 Patch		20 00		

TOWN OF LEXINGTON—DEPT. OF PUBLIC WORKS  
SEWER DIVISION

DATE .....

NO. ....

The undersigned applies for the construction of a particular sewer connecting No. ....  
Street and hereby agrees to comply with the Rules and Regulations governing the construction and use of Particular  
Sewers, as now or at any future time established by the Board of Selectmen.


Am't of estimate \$.....

Am't Paid \$.....

..... Owner

Sketch of Service Here

97

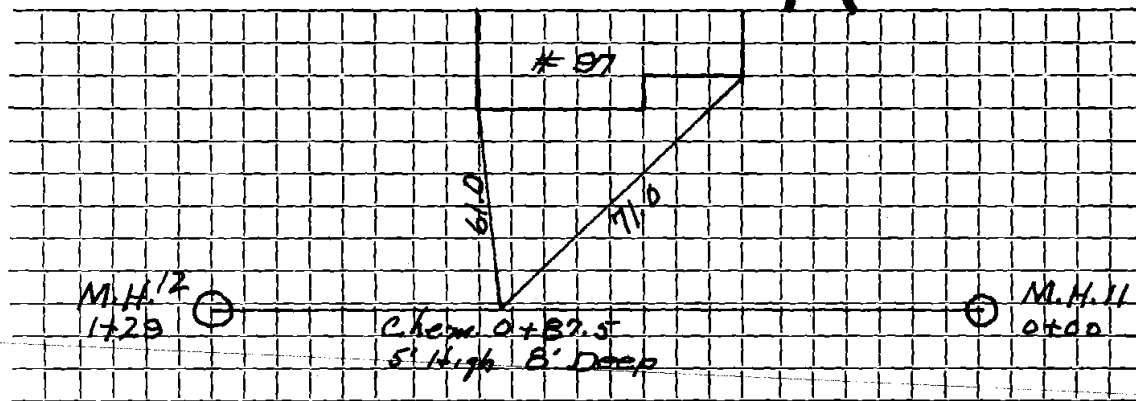

Connection made in ..... Street.

Work completed ..... 19..

Remarks: