

Name Edward Sahatjian

Service No. 95

Address # 98 Cedar St.

Location

Kind of Pipe

Size

Size of Main

~~Repair/ Renewal~~ - New Service

Location Comm 9-25-61

Date	Material	Amount	Total	Date		Amount
8-11-61	Labor	45.42		7-26-61	Deposit	125.00
	103 O.H.	4.54	49.96	9-25-61	Refund	23.93
	32' 6" Transite pipe @.78		24.96			101.07
	1 6" 90° Transite Elbow		5.40			
	1 1/2 hrs. Town Shovel @6.50		9.75			
	2 hrs. Trucking @3.00		6.00			
	5 x 3 Patch		5.00			
			101.07			
	<b>Labor</b>					

TOWN OF LEXINGTON—DEPT. OF PUBLIC WORKS

SEWER DIVISION

DATE .....

NO. ....

The undersigned applies for the construction of a particular sewer connecting No. ....  
Street and hereby agrees to comply with the Rules and Regulations governing the construction and use of Particular  
Sewers, as now or at any future time established by the Board of Selectmen.


Am't of estimate \$.....

Am't Paid \$.....

..... Owner

Sketch of Service Here

98

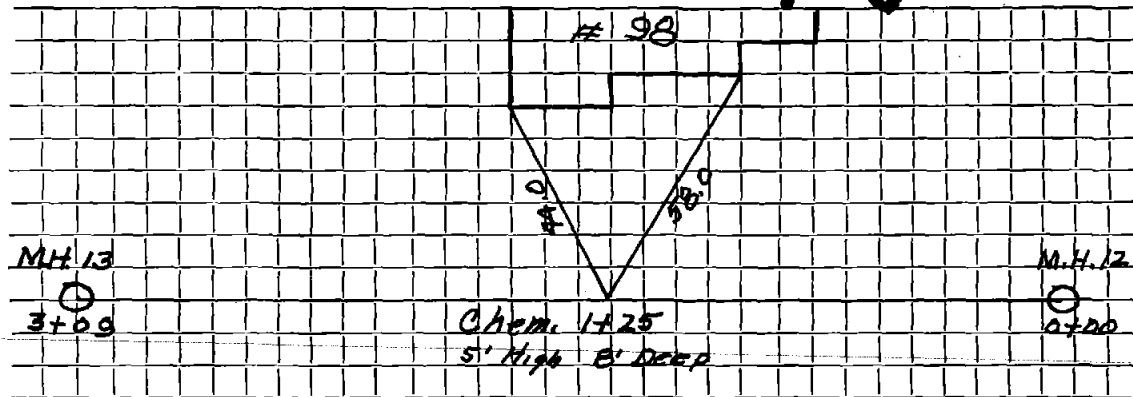

Connection made in ..... Street.

Work completed ..... 19..

Remarks: