


DATE 6/8/2023

TOWN OF LEXINGTON — BOARD OF PUBLIC WORKS

SEWER DIVISION

Sketch of Service Here

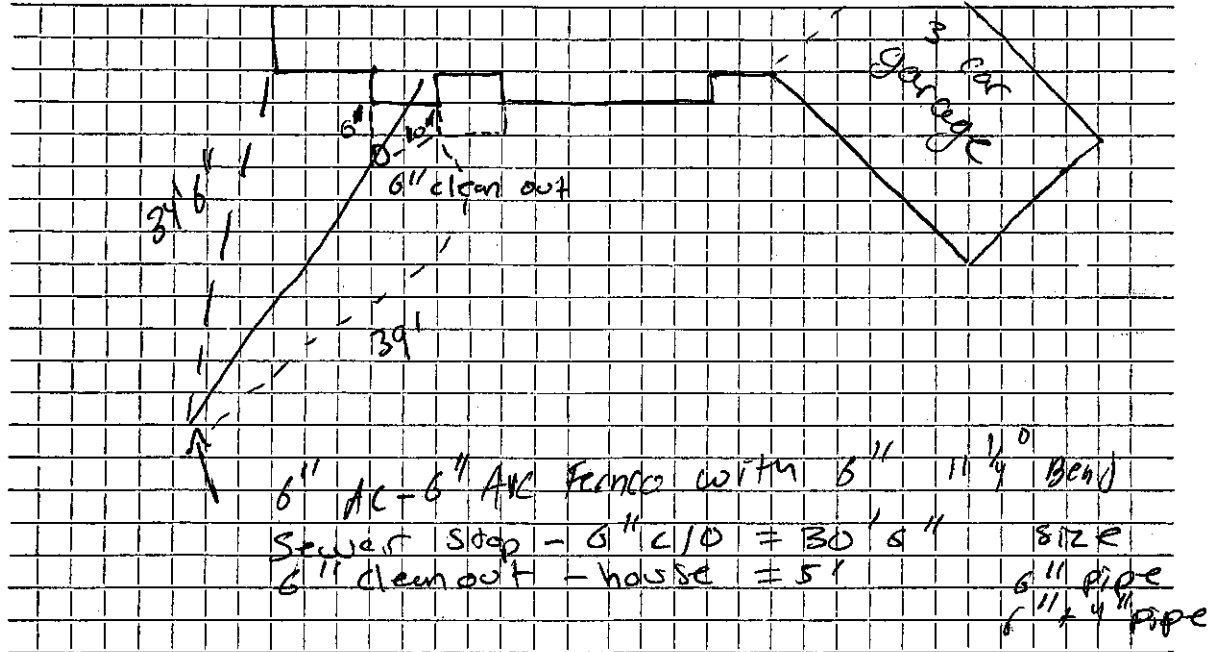

Connection made in S cedar wood terrace Street. Work completed

Remarks: JM M. Cloughlin