

Name Clinton Fleming

Service No. 81

Address 10 Centre Street

Location

Kind of Pipe

Size

Size of Main

~~Repair/Extension~~ New Service

W^o # 8736

Location JUN 29 1964


Date	Material	Amount	Total	Date	Amount
5-20-64	Labor	83.98		5-6-64	250 00
5-21-64	1" . . .	6.96	90 94	5-19-64	61 86
	10% O.H.	9 09	100 03		188 14
	36' 6" Transite pipe @.82		29 52		
	1 90° Transite Elbow		4 09		
	20 X 3 Patch		20 00		
	3 Hrs. Town Shovel		19 50		
	2 Hrs. Trucking @3.00		6 00		
			188 14		

Deposit
Refund

DATE _____

TOWN OF LEXINGTON — BOARD OF PUBLIC WORKS
SEWER DIVISION

Sketch of Service Here

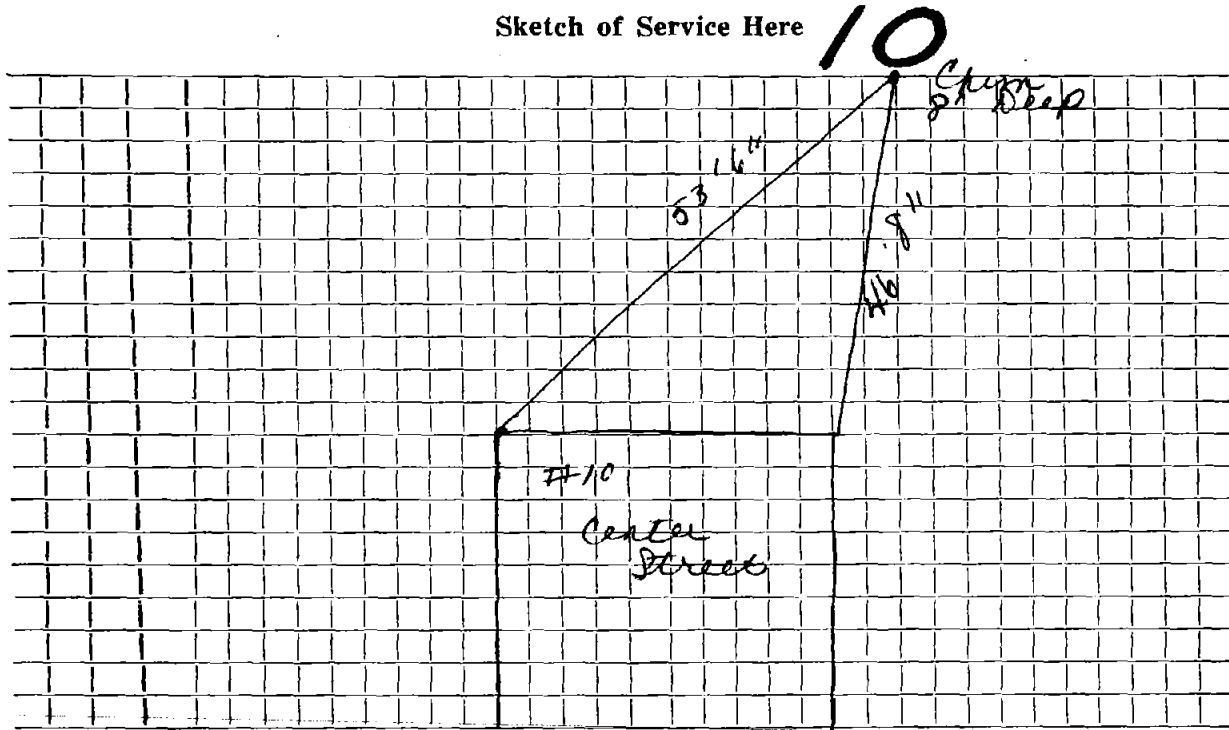

Connection made in Street. Work completed

Remarks:
.....
.....