

Name Donna Realty Trust

Service No. 136

Address 29 Center Street

Location

Kind of Pipe

Size

Size of Main

~~Repair~~ Renewal - New Service w.o. #7146 Valeri #1509

Location DEC 22 1969

Date	Material	Amount	Total	Date	Amount
12/1/69	Labor		55 74	11-25-69	200 00
	10% O.H.		5 57	12-22-69	97 94
	25' 6" Transite .88		22 00		102 06
1	Saddle		5 50		
1½	Hrs. shovel 6.50		9 75		
½	" trucking 3.00		1 50		
½	" loader 4.00		2 00		
			102 06		
12-3-69	25' 6" Transite pipe				
	10' 4" Cast Iron pipe				


DATE _____

TOWN OF LEXINGTON — BOARD OF PUBLIC WORKS

SEWER DIVISION

Sketch of Service Here

29

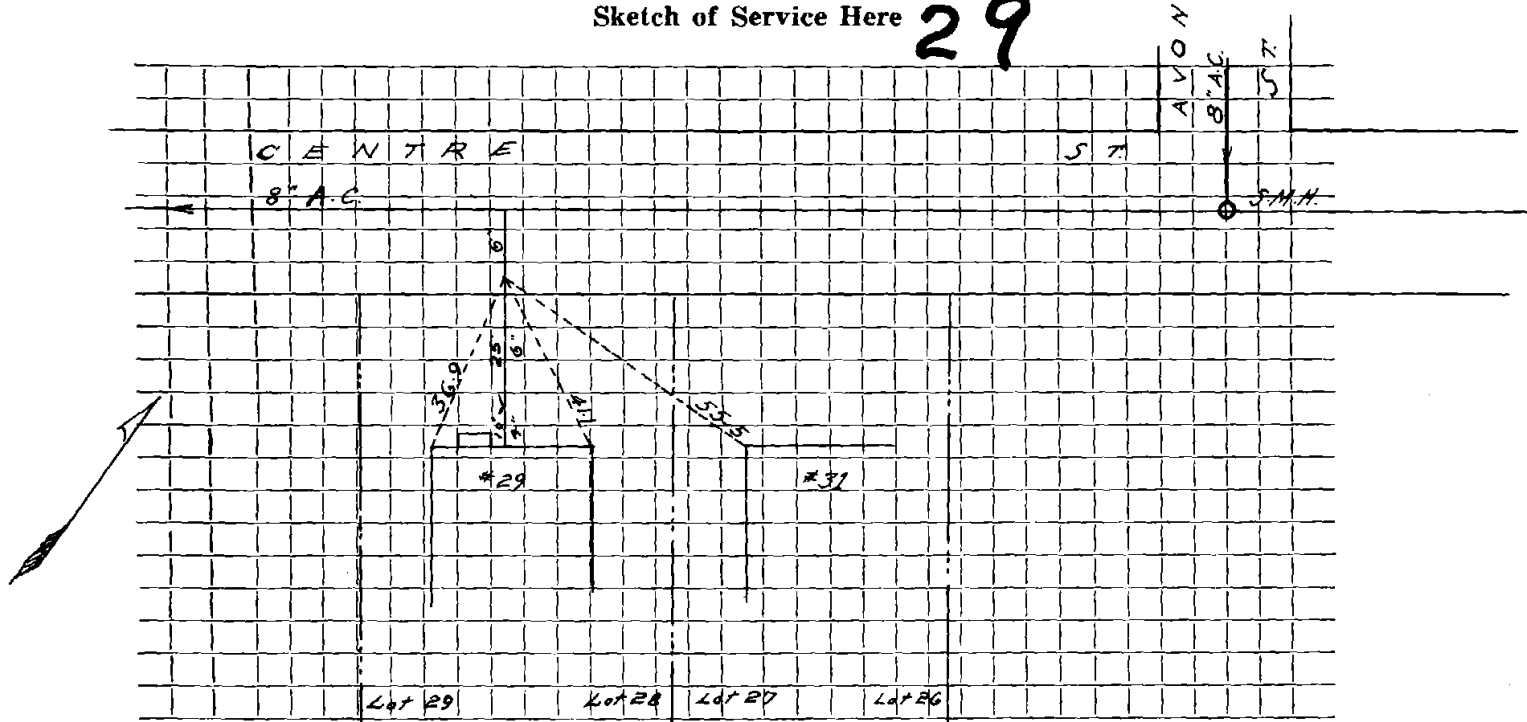

Connection made in Street. Work completed

Remarks:

.....

.....