

Service No.

Name :

Address :

33 Centre St (Garage)

Location

Kind of Pipe

Size

Size of Main

Repair—Renewal—New Service


Location

Date	Material	Amount	Total	Date	Amount
5-5-03	6'-4" PVC				
	106'-6" PVC				
	4x6 PVC @ PVC Franco				
	6" - 90° Elbow				
	4x4x6 wye clean out				

DATE \_\_\_\_\_

**TOWN OF LEXINGTON — BOARD OF PUBLIC WORKS**  
**SEWER DIVISION**

Sketch of Service Here

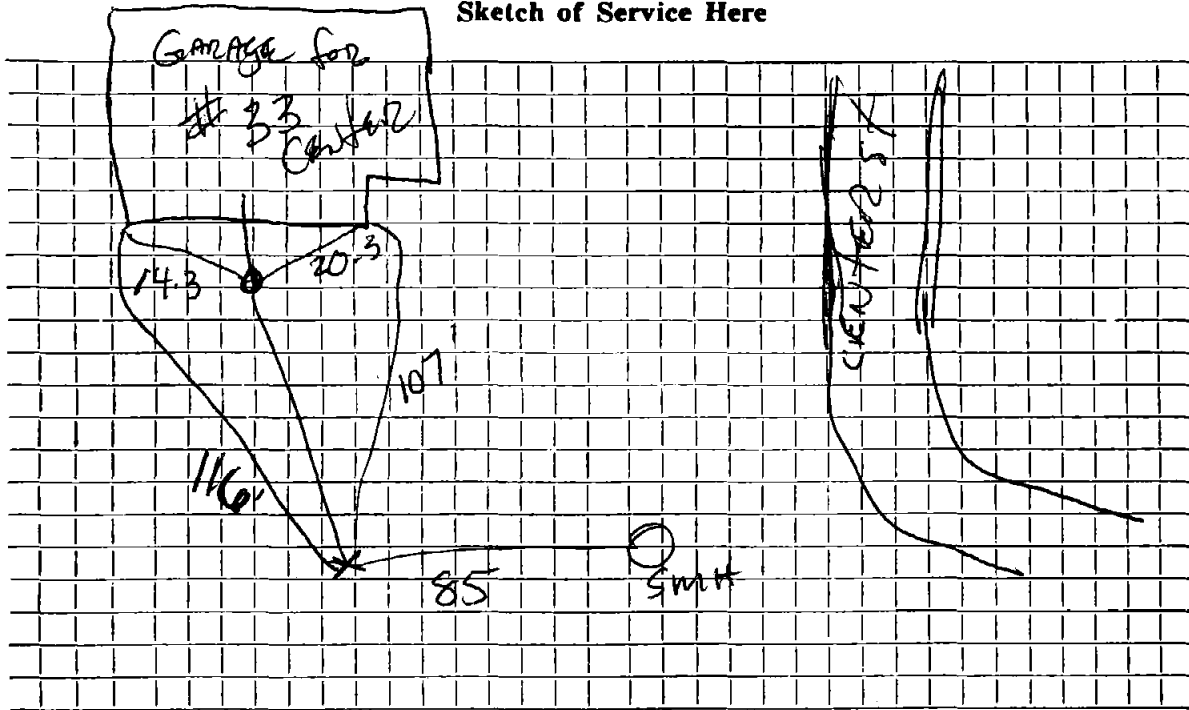

Connection made in ..... Street. Work completed .....

Remarks: ..... SERVICE from GARAGE to EASEMENT in backyard .....