

Name **John P. DeNapoli**
 Address **33 Center St**

Service No. **119**

Location

Kind of Pipe

Size

Size of Main

~~Repair~~ ~~Renewal~~ **New Service**

Location *Comm. 11-24-58*

Date	Material	Amount	Total	Date	Amount
8/11/58	Labor	38 55		<i>7-3-58</i>	<i>Deposit</i> 136 00
	10% Overhead	3 86	42 41	<i>11-24-58</i>	<i>Retard</i> 19 86
	50'-6" Transit Pipe @.70		35 00		<i>94 16</i>
	2 hrs. Town Shovel @ 6.50		13 00		
	1 hr. Trucking @.75		75		
	1 hr. Hough Loader @ 3.00		3 00		
			94 16		
	Labor				

TOWN OF LEXINGTON—DEPT. OF PUBLIC WORKS
SEWER DIVISION

DATE.....

NO.


The undersigned applies for the construction of a particular sewer connecting No.....
Street and hereby agrees to comply with the Rules and Regulations governing the construction and use of Particular
Sewers, as now or at any future time established by the Board of Selectmen.

Am't of estimate \$.....

Am't Paid \$.....

..... Owner

Sketch of Service Here

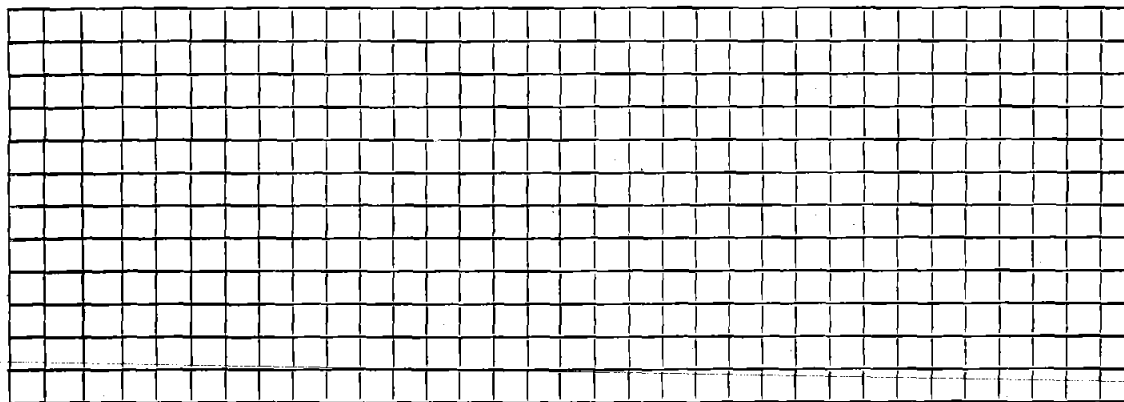

Connection made in..... Street.

Work completed.....19..

Remarks: