


DATE _____

TOWN OF LEXINGTON — BOARD OF PUBLIC WORKS

SEWER DIVISION

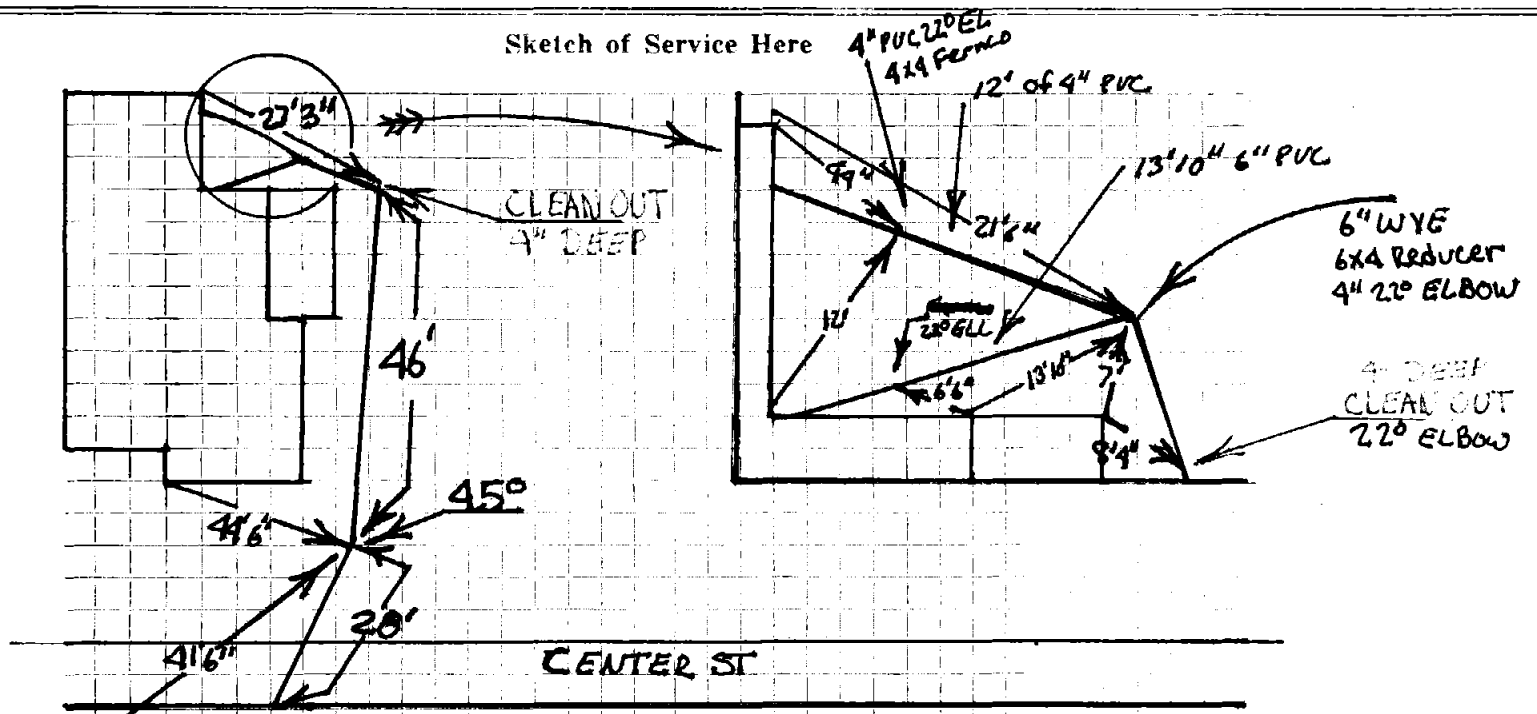

Connection made in $\text{Ø } \frac{12}{12}$ Street. Work completed

Remarks: