

Name

Service No.

Address 11 CHADBOURNE RD.

Location

Kind of Pipe PVC

Size 6"

Size of Main 8"

Repair—Renewal—New Service


Location

Date	Material	Amount	Total	Date	Amount
11-3-80	20' 6" PVC @	14.00	= 280.00		
8.17.99	Inside installed			11-3-80	
	66' - 6" PVC pipe			20' 6" PVC	
	10' - 4" PVC pipe				
	1- 4X6 PVC to PVC FRANKO				

DATE 11-18-80

TOWN OF LEXINGTON — BOARD OF PUBLIC WORKS
SEWER DIVISION

Sketch of Service Here

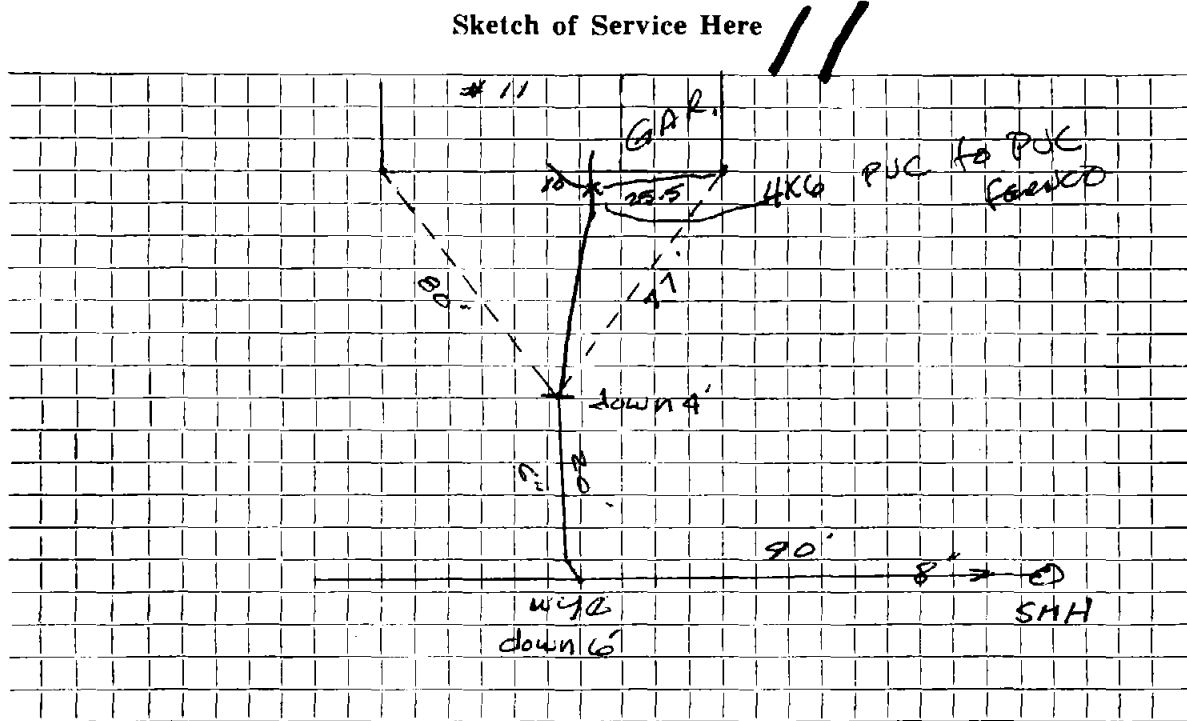

Connection made in CHADBOURNE RD. Street. Work completed

Remarks:
.....
.....