


DATE 11-18-80

TOWN OF LEXINGTON — BOARD OF PUBLIC WORKS
SEWER DIVISION

Sketch of Service Here **15**

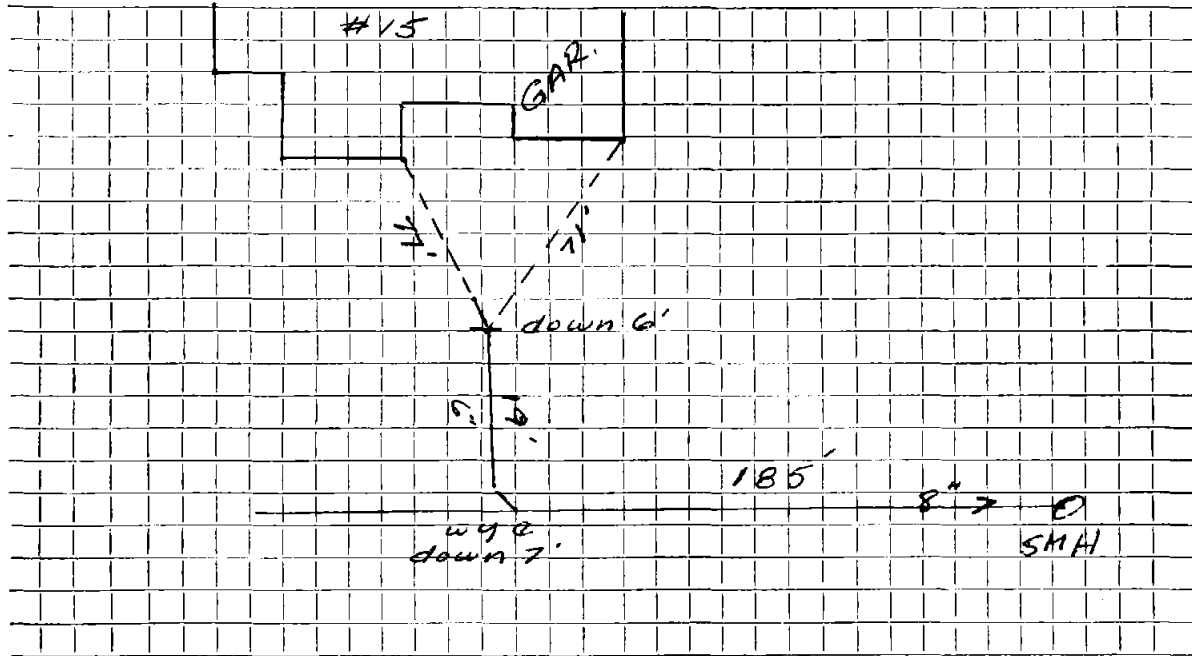

Connection made in CHADBOURNE RD. Street. Work completed

Remarks:
.....
.....