




DATE 11-18-80

TOWN OF LEXINGTON — BOARD OF PUBLIC WORKS  
SEWER DIVISION

Sketch of Service Here

16

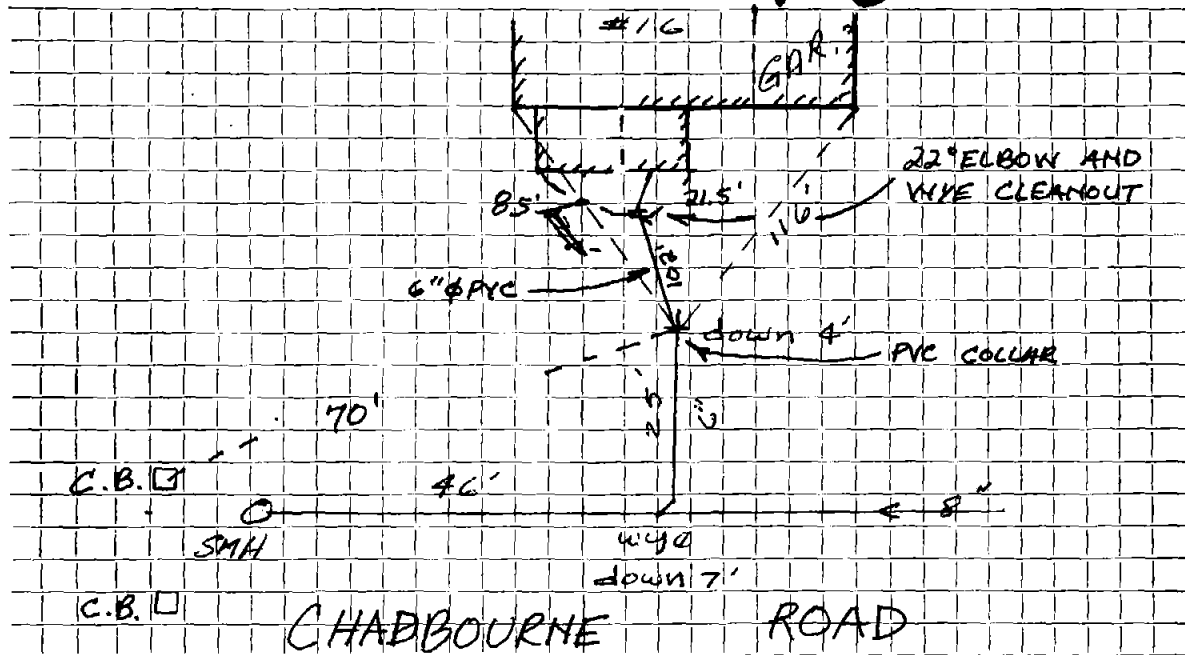

Connection made in CHADBOURNE RD. Street. Work completed .....

Remarks: .....