


DATE 11-18-80

TOWN OF LEXINGTON — BOARD OF PUBLIC WORKS
SEWER DIVISION

Sketch of Service Here

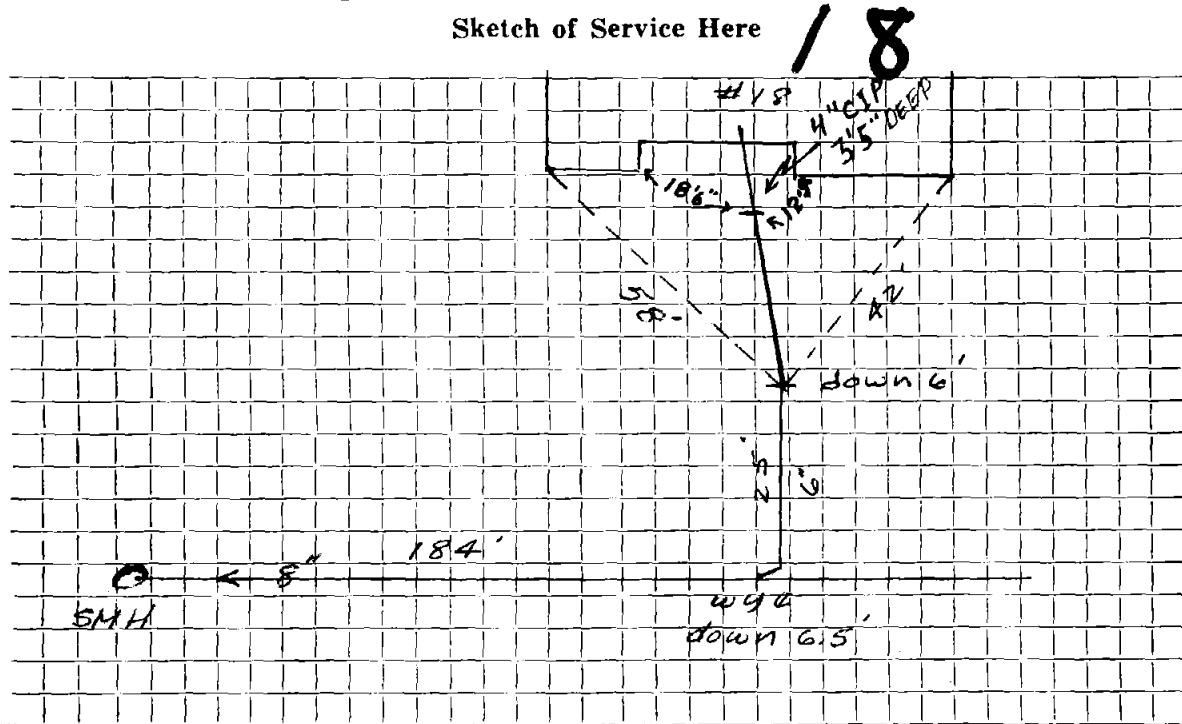

Connection made in CHADBOURNE RD. Street.

Work completed

Remarks:

.....
.....