

Name Richard Testa

Service No. 45

Address 3 CHADBOURNE RD

Location

Kind of Pipe PVC

Size 6"

Size of Main 8"

~~Repair~~ ~~Renewal~~ New Service D.J. Faulkner

Location


Date	Material	Amount	Total	Date	Amount
<del>11-5-80</del>	<del>20' 6" PVC @</del>	<del>\$14.00 =</del>	<del>\$280.00</del>	<del>11-28-87</del>	<del>280.00</del>
<del>12-10-80</del>	<del>13' 6" PVC @</del>	<del>N.C. =</del>	<del>0.00</del>		
10/27/87	20' 6" PVC			12-10-80	
	10' 4" Cast			33' 6" PVC	
	1 4" 22°				
	2 6" 22° Bends				
	1 4" x 6" Fernco				
	1 6" x 6" Fernco				



DATE 12-11-80

TOWN OF LEXINGTON — BOARD OF PUBLIC WORKS  
SEWER DIVISION

Sketch of Service Here **3**

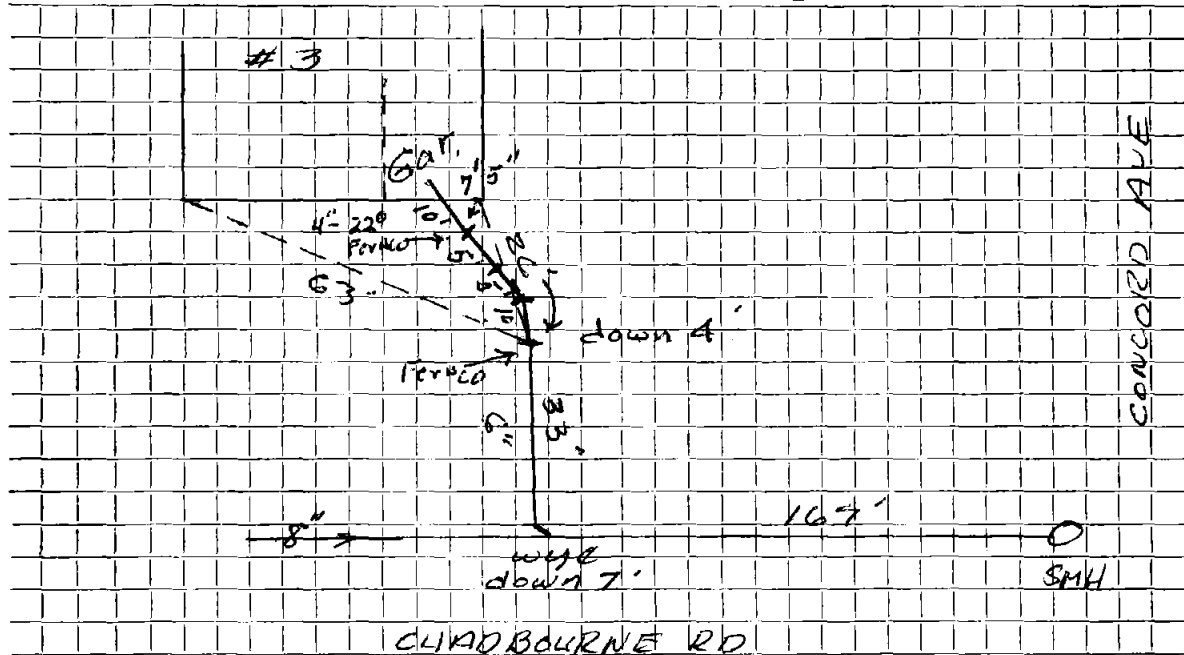

Connection made in CHAUBOURNE RD. Street. Work completed .....

Remarks: .....

.....

.....