

Name Earl Thompson

Service No. 79

Address 7 CHADBOURNE RD.

Location

Kind of Pipe PVC

Size 6"

Size of Main 8"

Repair/Remove - New Service Hurley Plumbing #3559


Location JAN 19 1981

Date	Material	Amount	Total	Date	Amount
11-5-80	47' 6" PVC @	14.00	= \$658.00	12-1-80	Deposit 658.00
12-3-80	43' P.V.C pipe				
	10' 4" Iron pipe				
	1 22 1/2° Bend			11/5/80	OUTSIDE
				12/3/80	47' 6" P.V.C. pipe
					1 Wye

DATE 11-18-80

TOWN OF LEXINGTON — BOARD OF PUBLIC WORKS
SEWER DIVISION

Sketch of Service Here 7

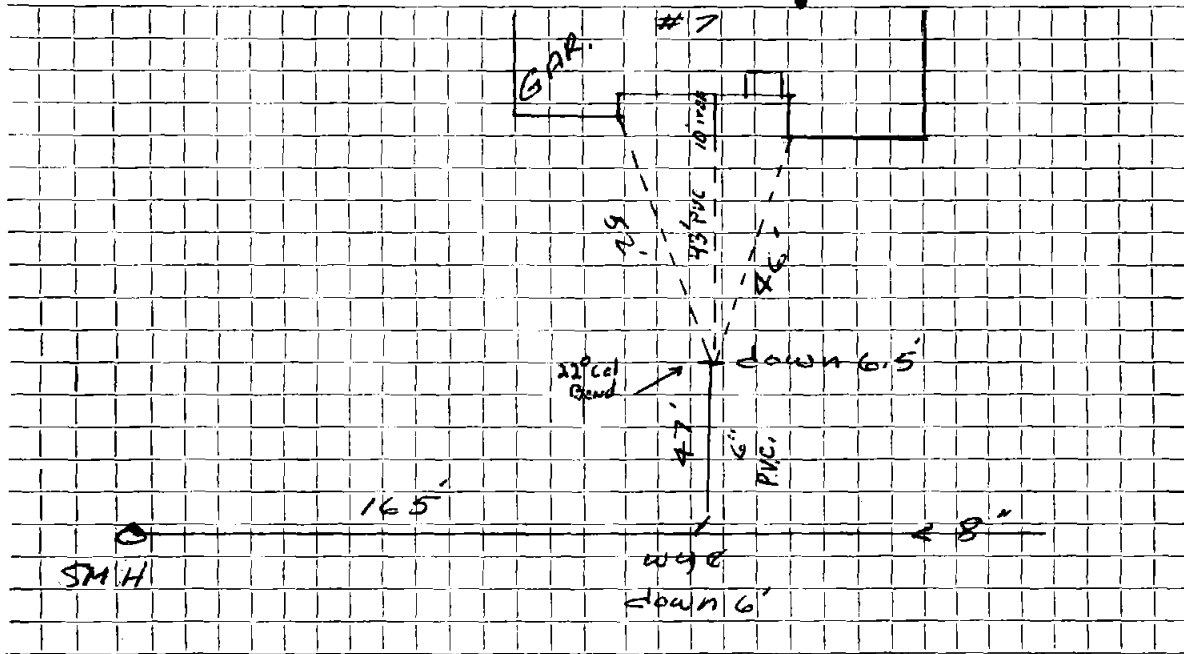

Connection made in CHADBOURNE RD. Street. Work completed

Remarks: 25' out from house water crosses Sewer Pipe.