


DATE June 28, 1976

TOWN OF LEXINGTON — BOARD OF PUBLIC WORKS
SEWER DIVISION

Sketch of Service Here **14**

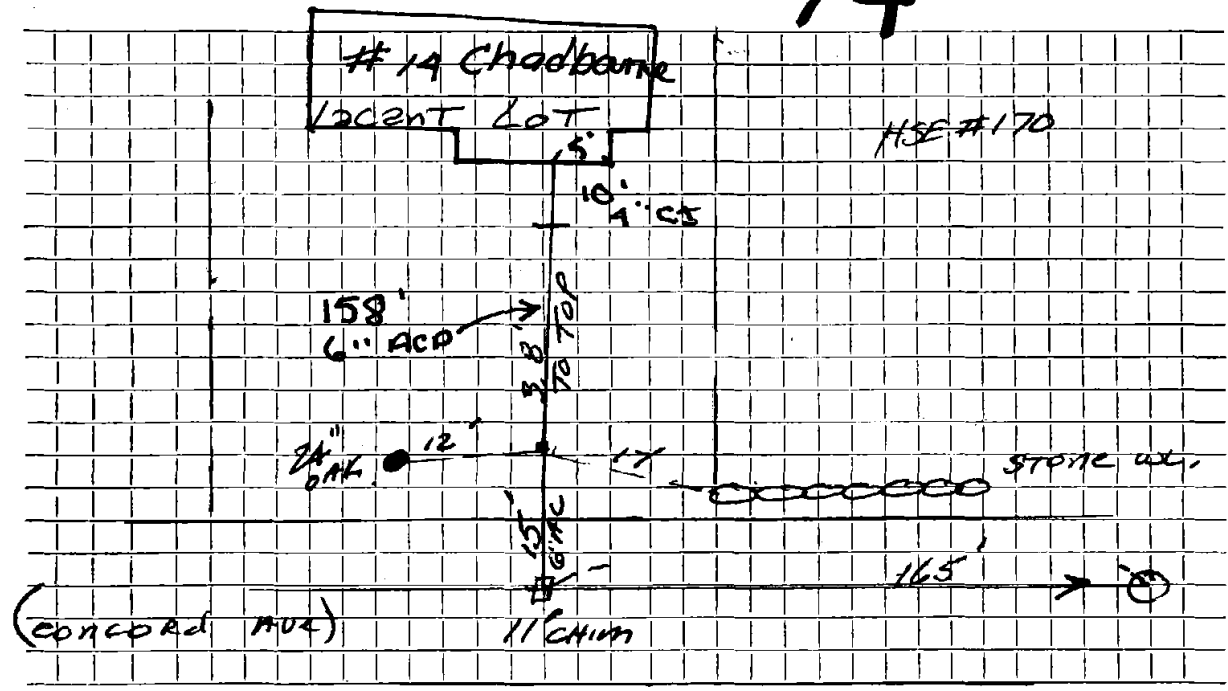

Connection made in .. CONCORD AVE .. Street. Work completed

Remarks: