




DATE 11-18-80

TOWN OF LEXINGTON — BOARD OF PUBLIC WORKS  
SEWER DIVISION

Sketch of Service Here

9

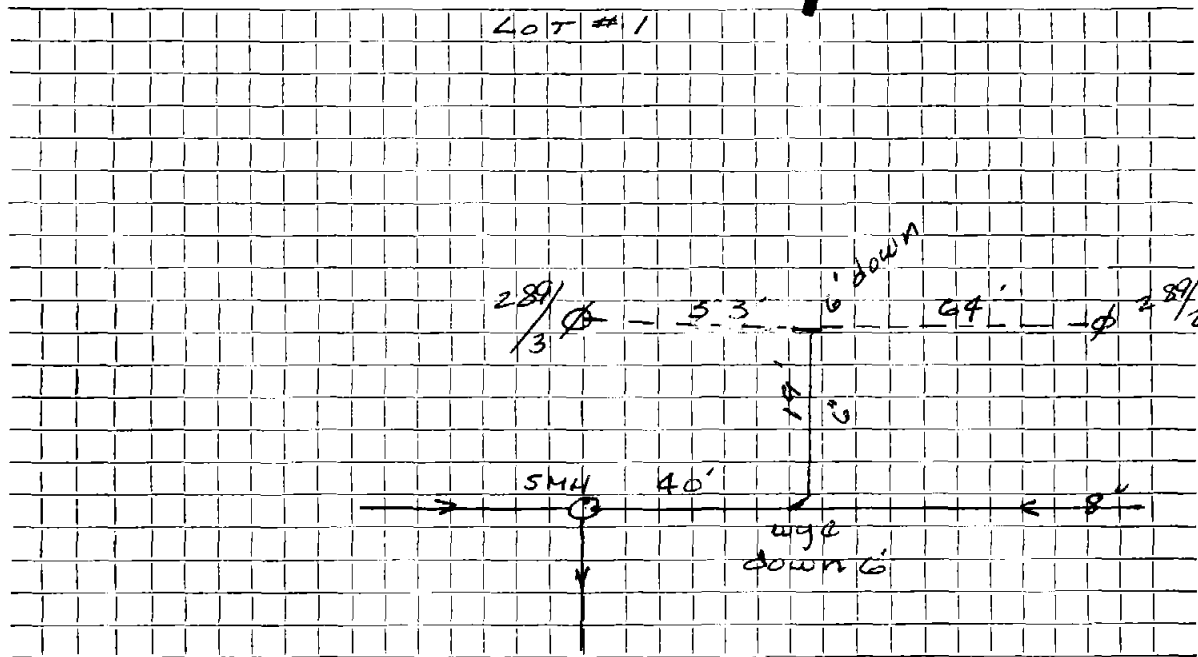

Connection made in CHADBOURNE RD Street. Work completed .....

Remarks: .....

.....

.....