

Name Frank G. Jason

Service No. 5

Address 2 Chandler Street

Location

Kind of Pipe

Size

Size of Main

~~Repair - Renewal - New Service~~ W.O. #9551


Location MAY 17 1965

Date	Material	Amount	Total	Date	Amount
2-26-65					
2-31-65	Labor	188.56		2-23-65	368.28
	10% C.H.	18.86	207.42		
	80' 6" Transite pipe @.82		65.60		
	1 90° Transite Elbow		4.09		
	1 11½° Transite Elbow		2.35		
	1 11½° Transite Bend @4.09		4.09		
	1 6" Wye		4.09		
	1 6 x 12 Nipple		1.21		
	1 End Cap		1.93		
	17 x 3 Patch		17.00		
	3 x 4 Patch		4.00		
	5 hrs. Trucking @3.00		15.00		
	1 hr. Compressor		5.00		
	1 hr. Loader		4.00		
	5 hrs. Town Shovel @6.50		32.50		
			368.28	1-17-65	Tags
				1-13-65	Tags

DATE _____

TOWN OF LEXINGTON — BOARD OF PUBLIC WORKS
SEWER DIVISION

Sketch of Service Here **2**

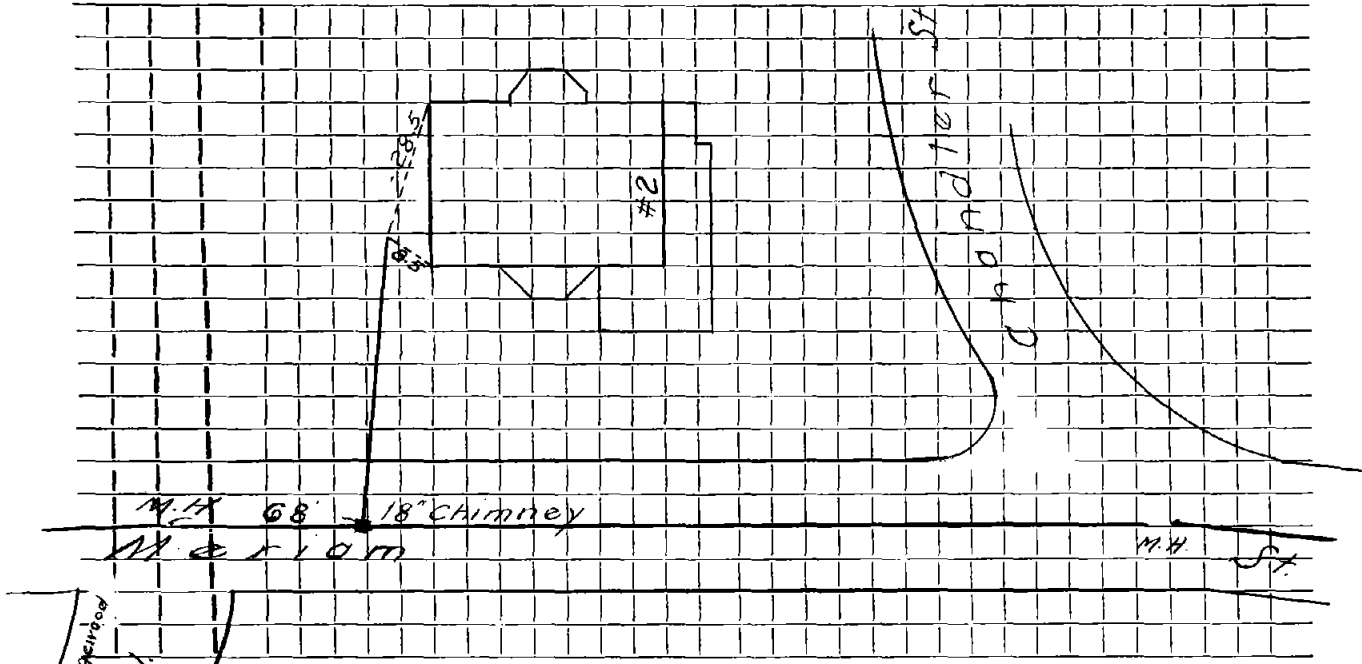

Connection made in _____ Street. Work completed _____

Remarks: Original Service 4-11-28