

Name Howard F. Potter

Service No. 124

Address 6 Chandler Street

Location

Kind of Pipe

Size

Size of Main

~~Repair~~ Renewal ~~New Service~~ W.O. #8219


Location *Comm 2-10-64*

Date	Material	Amount	Total	Date	Amount
10-25-63	Labor	80.26		10-1-63	200.00
10-28-63	"	27.78	108.04	3-23-64	13.88
	10% O.H.	10/80	118.84		213.88
	47' 6" Transite pipe @.82		38.54		
	5 hrs. Town Shovel @6.50		32.50		
	3 hrs. Trucking @3.00		9.00		
	5 yds. Loam @3.00		15.00		
			213.88		

DATE _____

TOWN OF LEXINGTON — BOARD OF PUBLIC WORKS
SEWER DIVISION

Sketch of Service Here **6**

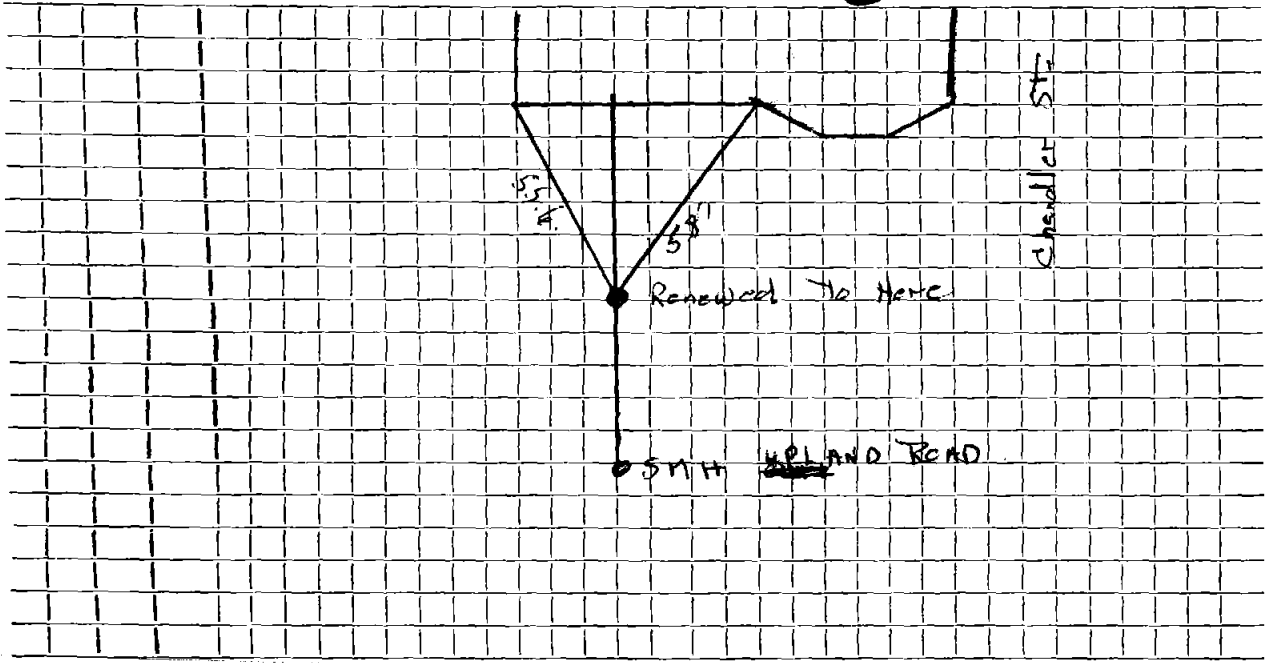

Connection made in Street. Work completed

Remarks: Original Service 11-10-28

.....
.....