

Name Chisholm Construction Co., Inc.

Service No. 139

Address ~~XX CHANDLER STREET~~ 9 Chandler Street (1965 Per Eng.)

W.O.#9143

Location

Kind of Pipe

Size

Size of Main

~~Repair/Remove~~ — New Service Lexington Sewerage Co. Permit #81


Location DEC 28 1964

Date	Material	Amount	Total	Date	Amount
8-28-64	Labor	112 51		8-21-64	100 00
	10% O.H.	11 25	123 76	15-65	126 70
20	6" Transite Pipe @.82		16 40		226 70
1	90° Elbow		4 09	10-6-93	
21	X 3 Patch		21 00	12' 6" PVC	
32	Dynamite Sticks @.27		8 64	2 6"X6" Fernco	
10	Blasting Caps @.28		2 80		
7½	Ton Fill @1.00		7 50		
7	¾ Ton Bank Gravel @1.10		8 51		
2	Hrs. Town Shovel @6.50		13 00		
3	Hrs. Compressor @5.00		15 00		
2	Hrs. Town Truck @3.00		6 00		
			226 70		
Sept 15, 1964	50' 6" Transite				

DATE \_\_\_\_\_

**TOWN OF LEXINGTON — BOARD OF PUBLIC WORKS**  
**SEWER DIVISION**

Sketch of Service Here **9**

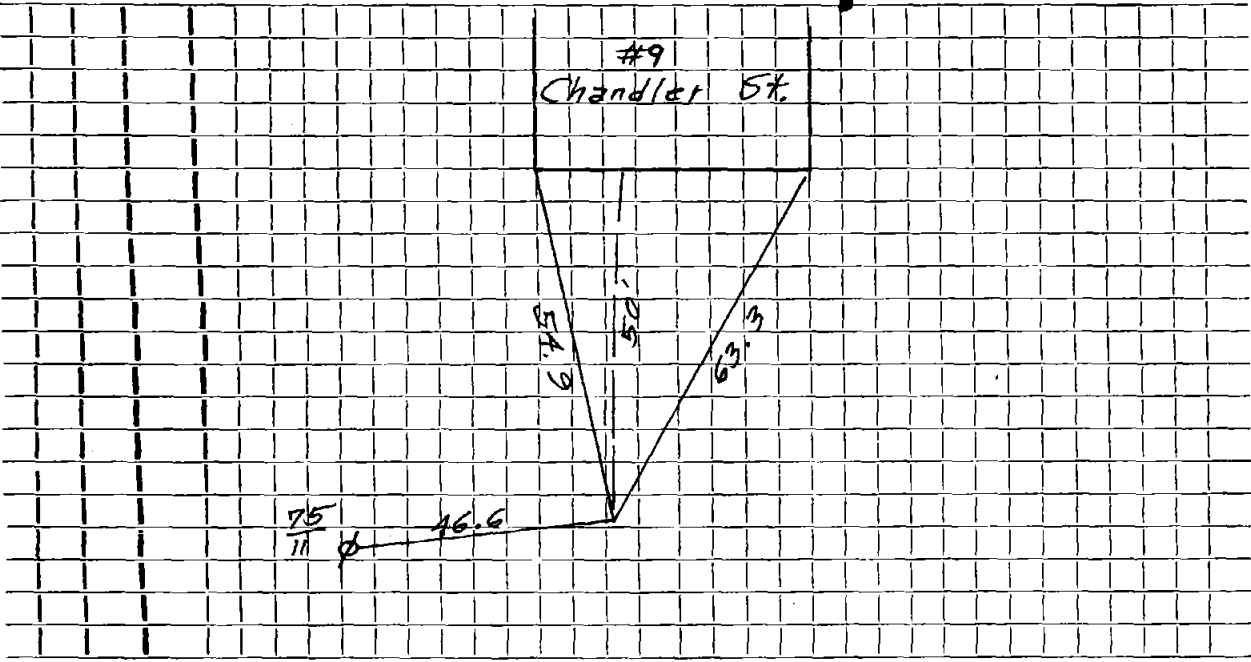

Connection made in ..... Street. Work completed .....

Remarks: .....  
.....  
.....