

Name Mr. Manuel Madeiros

Service No: 20 143

Address Charles Street

Location

Kind of Pipe

Size

Size of Main

Repair ~~Renewal~~ — New Service

Location

Date	Material	Amount	Total	Date	Amount
50'	4" Sewer Pipe @ .20	10 00			
10'	4" Soil " @ 6.60	6 00			
1	6" Y	70		May 12	15 00
1	6 x 4 Reducer	70		Oct. 11 1926	15 00
	Sulphur & Jute	1 50		Sept. 14 Abate	15 00
	Trucking	75	19 65	Dec. 14 1926 Cash	58 45
	Total Labor		72 87	TOTAL	103 45
	15% Overhead		10 93		
			103 45		
9/23	20 Hrs. Labor @ .55	11 00			
	5 " " @ .70	3 50			
9/24	11 " " @ .55	6 05			
	4 " " @ .70	2 80			
9/25	44 " " @ .55	24 20			
	8 2/3 Labor " @ .70	6 07			
9/26	35 " " @ .55	19 25			
		72 87			

Bailey Press, Boston

*P. 88 1/2*  
*12-31-26*

*77 45*

Name Harry Yates  
 Address ~~15~~ Charles Street

Service No. 32 144

Kind of Pipe Location Size Size of Main  
~~Repair~~ ~~Renewal~~ - New Service Location

Date	Material	Amount	Total	Date	Amount
<i>P. 20 28</i>	50' 6" Sewer Pipe @.30	15 00			
	$\frac{1}{2}$ Stick Dyn. @.50	25		<i>May 8 1925 - Cash</i>	<i>75 00</i>
	1 Cap	08			
	Sulphur & Jute	2 00			
	Trucking	75	18 08		
<i>5/12/28</i>	78 Hours Labor @.55	42 90			
	3 " " @.60	1 80			
	7 " " @.65	4 55	49 25		
	15% Overhead		7 39		
			74 72		
<i>June 12</i>	Labor <i>Return</i>		<i>28</i>		
			<i>75 00</i>		

Hadley Press, Inc., Washington

Page of lumber

TOWN OF LEXINGTON - BOARD OF PUBLIC WORKS

SEWER DIVISION

DATE May 7, 1928

NO. \_\_\_\_\_


The undersigned applies for the construction of a particular sewer connecting No. 19 Charles Street Street and hereby agrees to comply with the Rules and Regulations governing the construction and use of Particular Sewers, as now or at any future time established by the Board of Selectmen.

Am't. of Estimate \$ 75<sup>00</sup>

Am't. Paid \$ 75<sup>00</sup>

74 W Gates Owner

Sketch of Service Here

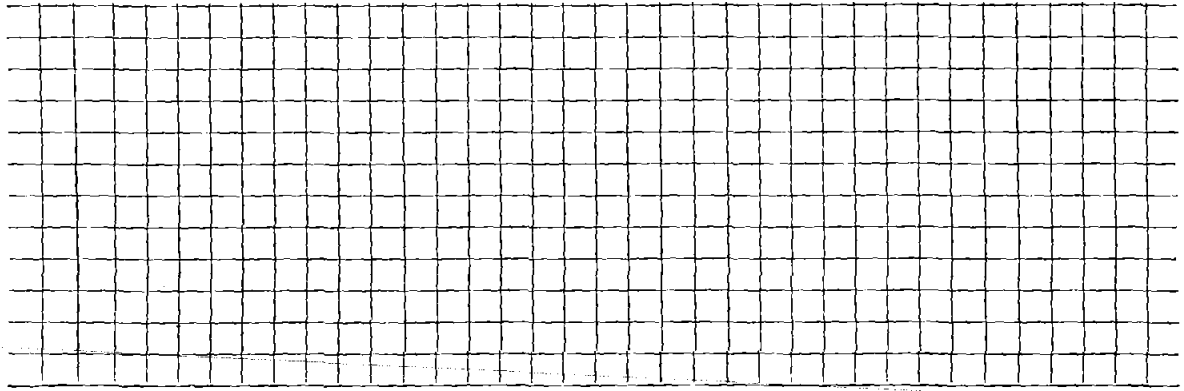

Connection made in \_\_\_\_\_ Street. Work completed \_\_\_\_\_ 19

Remarks: