

Name N.Y. Bros. Trust, 435 Lincoln Street

Service No. 68

Address 18 Charles Street

Location

Kind of Pipe

Size

Size of Main

~~Repair or Renewal~~ New Service W.O. #2580

Dr. Pellet # 2571

Location FEB 10 1975


Date	Material	Amount	Total	Date	Amount
10-9-74	Labor 104.89			10-2-74	Deposit 350.00
10-10-74	" 25.04			2-10-75	Paid by W.H.C. #33 30.39
10-11-74	" 8.52	138.45			280.39
	10 % O.H.V	13.85	152.30		
	20' 6" Transite Pipe @1.24		24.80		
	1 6" Cap		2.89		
	1/2 Bag Cement		1.10		
	4 Ton Patch @12.15		48.60		
	1 Yd. Loam		5.00		
	1 Lb. Grass Seed		.95		
	5 Hrs. Trucking @3.00		15.00		
	3 Hrs. Pick up @1.50		4.50		
	2 1/2 Hrs. Town Shovel @6.50		16.25		
	1 Hr. Roller @2.00		2.00		
	1 Hr. Trailer @2.00		2.00		
	1 Hr. Compressor @5.00		5.00		
10-24-74	30' 6" Transite pipe				
18'	4" Cast Iron pipe				
			\$280.39		

DATE _____

TOWN OF LEXINGTON — BOARD OF PUBLIC WORKS
SEWER DIVISION

Sketch of Service Here

18

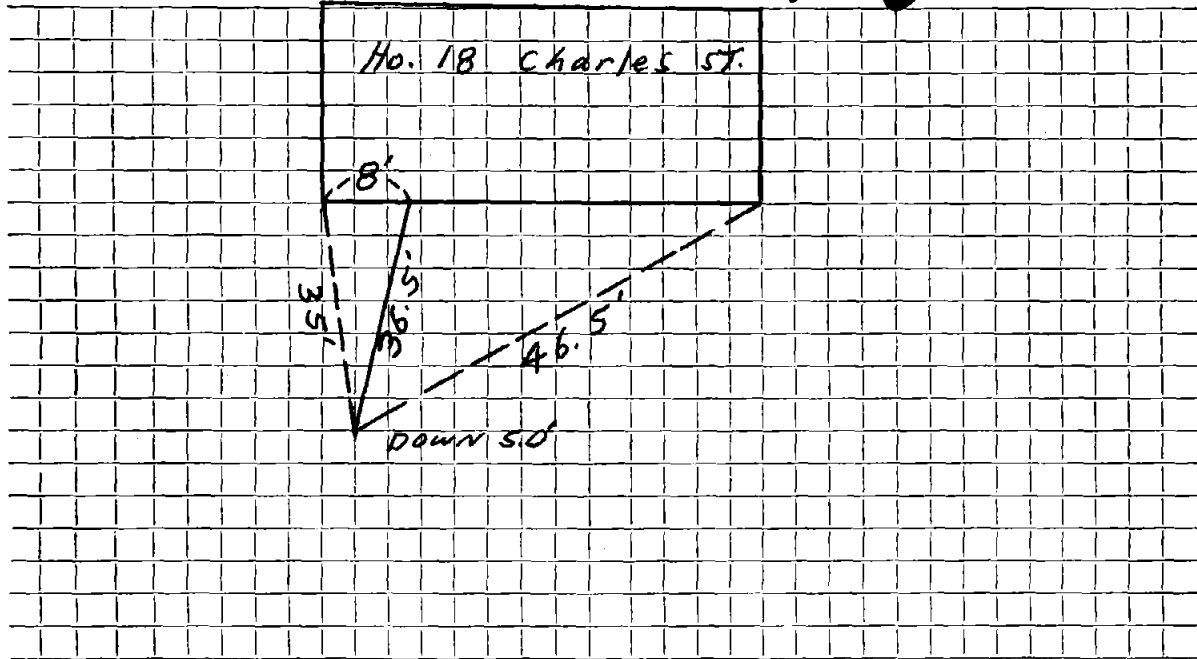

Connection made in Charles Street. Work completed

Remarks:

.....
.....