

Name Patrick J. Heaney

Service No. #11 1416

Address #19 Charles Street

Location same

Kind of Pipe

Size

Size of Main

~~Repair~~ ~~Renewal~~ New Service

Location

Date	Material	Amount	Total	Date	Amount
1937					
5/12	28 hrs. @ 55¢	15 40		May 13, 1937	70 00
Com 5-18-37	18 " 60¢	10 80	26 20	June 11 1937	144 48
	10% Overhead		2 62		55 52
	45' x 8" Sewer Pipe @ 20¢				
	45' 6" Sewer Pipe @ 20¢		9 00		
	1 6 x 6 Y		1 00		
	1 6 1/6" Bend		90		
	1 6 x 4 Reducer		90		
	Jointing Compound		2 80		
	2 hrs trucking @ 75¢		1 50		
	1 1/2 " compressor @ 3.00		4 50		
	Trench repairs 11 x 2 1/2		6 10		
			55 52		
	Labor				

Hadley Press, Inc., Lexington

TOWN OF LEXINGTON—BOARD OF PUBLIC WORKS

SEWER DIVISION

DATE May 5 1937

NO. _____


The undersigned applies for the construction of a particular sewer connecting No. 19 Charles Street Street and hereby agrees to comply with the Rules and Regulations governing the construction and use of Particular Sewers, as now or at any future time established by the Board of Selectmen.

Am't. of Estimate \$ 70⁰⁰ owner digs.

Am't. Paid \$ _____

Patrick J. Heaney, Owner

Sketch of Service Here

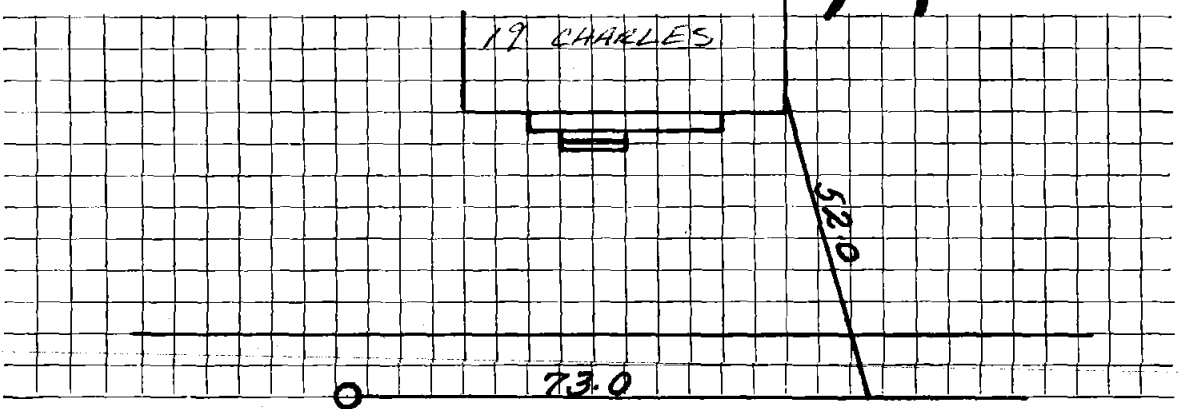

Connection made in _____ Street. Work completed _____ 19

Remarks: