

Name Stanley Doucette
 Address 20 Charles Street

Service No. 5 147

Location

Kind of Pipe

Size

Size of Main

~~Repair - Renew~~ - New Service

Location

Date	Material	Amount	Total	Date	Amount
4/7/38	22 hrs. @ 50¢	11 00		April 5, 1938 Deposited	35 00
<i>Com. 50¢</i>	20 " @ 55¢	11 00			
	21 " @ 60¢	12 60	34 60		
	10% Overhead		3 46		
	18' 6" Sewer Pipe @ 20¢		3 60		
	Jointing Compound		1 08		
	2 hrs. trucking @ 75¢		1 50		
			44 24		
	Flat Rate: \$35.00				
	Labor				

TOWN OF LEXINGTON—BOARD OF PUBLIC WORKS

SEWER DIVISION

DATE Apr. 5, 1938

The undersigned applies for the construction of a particular sewer connecting No. 20 Charles St. Street and hereby agrees to comply with the Rules and Regulations governing the construction and use of Particular Sewers, as now or at any future time established by the Board of Selectmen.


Am't. of Estimate \$ 25.00

Am't. Paid \$ _____

Stanley Dancette Owner

Sketch of Service Here

20

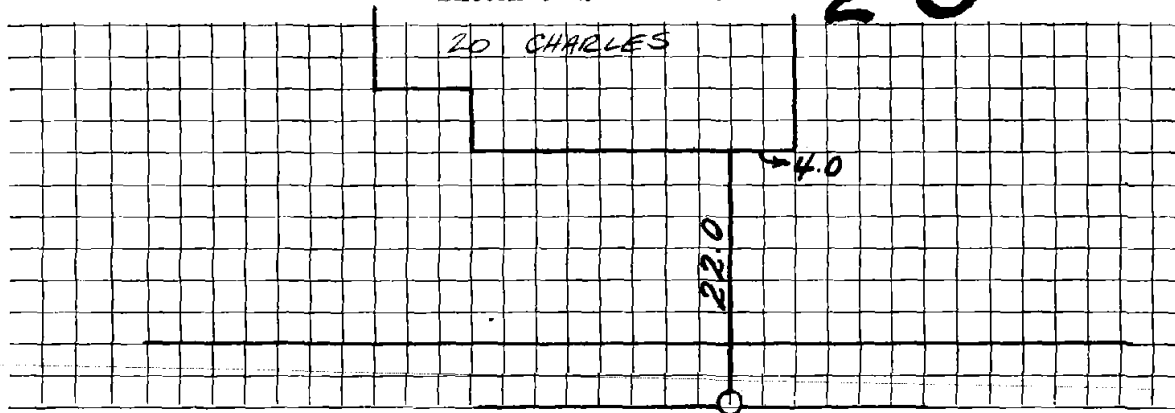

Connection made in _____ Street.

Work completed _____ 19

Remarks: