

Name Mr. Finlay McIsaac
 Address ~~35~~ Charles Street

Service No. 3 149

Location

Kind of Pipe

Size

Size of Main

~~Repair-Renewal~~—New Service

Location

Date	Material	Amount	Total	Date	Amount
P. 4-15-30 for 25.00	26'6" Sewer Pipe @.30	7 80			
P. 7-29-30 for 34.70	10'4" Iron Pipe @ .50	5 00		March 10 1930 - Cash	25 -
	Sulphur & Jute	1 04		May 13 1930 - Cash	34 70
	1 1/8" Bend	70			
	Trucking	<u>1 00</u>			
		15 54	15 54		
3/15/30	56 Hrs. Labor @.55	30 80			
	12 2/3 " " @.60	<u>7 60</u>	38 40		
	15% Overhead		<u>5 76</u>		
			59 70		
	Labor				

Hadley Press, Inc. Lexington

TOWN OF LEXINGTON - BOARD OF PUBLIC WORKS

SEWER DIVISION

DATE March 10 1930

NO. 38 Charles St


The undersigned applies for the construction of a particular sewer connecting No. 38 Charles St Street and hereby agrees to comply with the Rules and Regulations governing the construction and use of Particular Sewers, as now or at any future time established by the Board of Selectmen.

Am't. of Estimate \$ 75⁰⁰

Am't. Paid \$ 25⁰⁰

Finlay Mae Isaac Owner

Sketch of Service Here

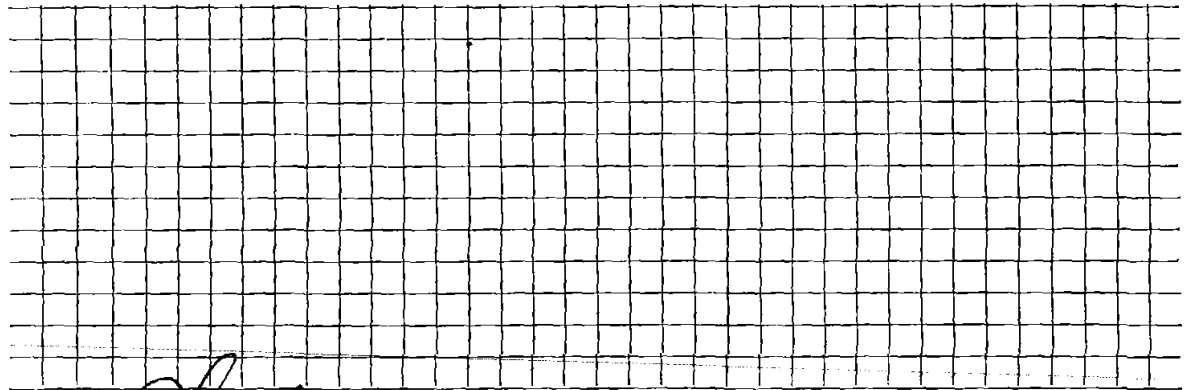

Connection made in Charles Street.

Work completed _____ 19

Remarks: