

Name Roy Cook

Service No. #10 / 150

Address 25 Charles Street

Location same

Kind of Pipe

Size

Size of Main

~~Repair - Renewal~~ New Service

Location

Date	Material	Amount	Total	Date	Amount
1937 5/3/	6 hrs. @ 50¢	3 00			
Com 5-18-37	33 1/2 @ 55¢	18 43			
	15 @ 60¢	9 00			
	50x 10% Overhead		30 43		
	30' 6" Sewer Pipe @ 20¢		6 00		
	Jointing Comp.		1 50		
	2 hrs compressor @ 3.00		6 00		
	2 " trucking @ .75		1 50		
	Trench Repairs 11 x 3		7 32		
			55 79		
	Labor				

April 28, 1937 Deposited
June 1, 1937 Refunded

65 00
 9 21
 55 79

Hadley Press, Inc., Lexington

TOWN OF LEXINGTON—BOARD OF PUBLIC WORKS
SEWER DIVISION

DATE _____


NO. _____

The undersigned applies for the construction of a particular sewer connecting No. _____
Street and hereby agrees to comply with the Rules and Regulations governing the construction and use of Particular
Sewers, as now or at any future time established by the Board of Selectmen.

Am't. of Estimate \$ _____

Am't. Paid \$ _____

_____ Owner

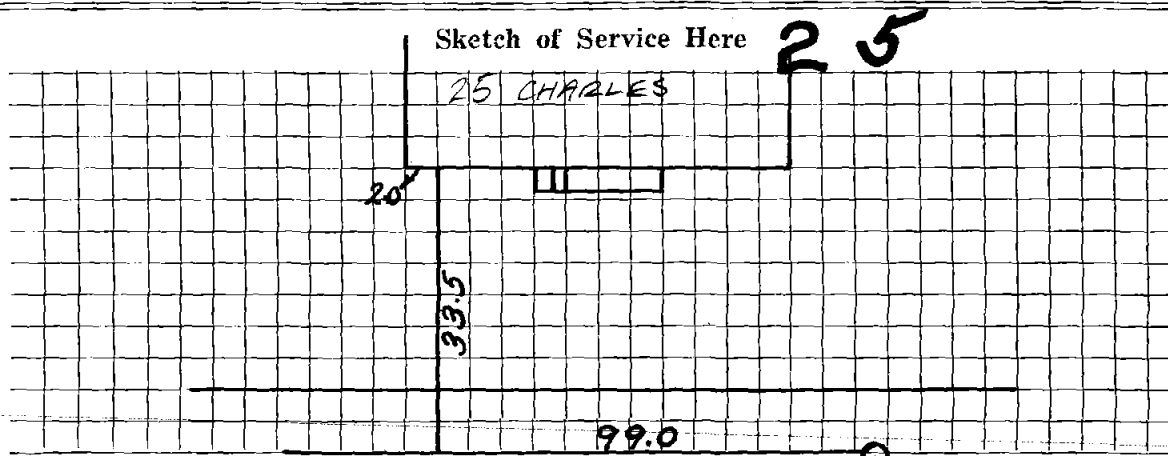

Connection made in _____ Street. Work completed _____ 19

Remarks: