

Name Mary Andresen
 Address 29 Charles St.

Service No. 6 131

Location

Kind of Pipe

Size

Size of Main

~~Repair-Renewal~~ - New Service

Location


Date	Material	Amount	Total	Date	Amount
7/12/33	43 6" Sewer Pipe @.15	6 45			
	Sulphur & Jute	1 72			
	Trucking	75	\$8 92	July 20 1933 - Cash	35 -
				Mar. 27 1934 - Labor	6 12
	44 Hrs. Labor @.50	22 00			
	10 " " @.60	6 00	28 00		
	15% Overhead		4 20		
			\$41 12		
	Labor				

Hadley Press, Inc., Lexington

DATE MAY 27 1998

TOWN OF LEXINGTON — BOARD OF PUBLIC WORKS
SEWER DIVISION

Sketch of Service Here

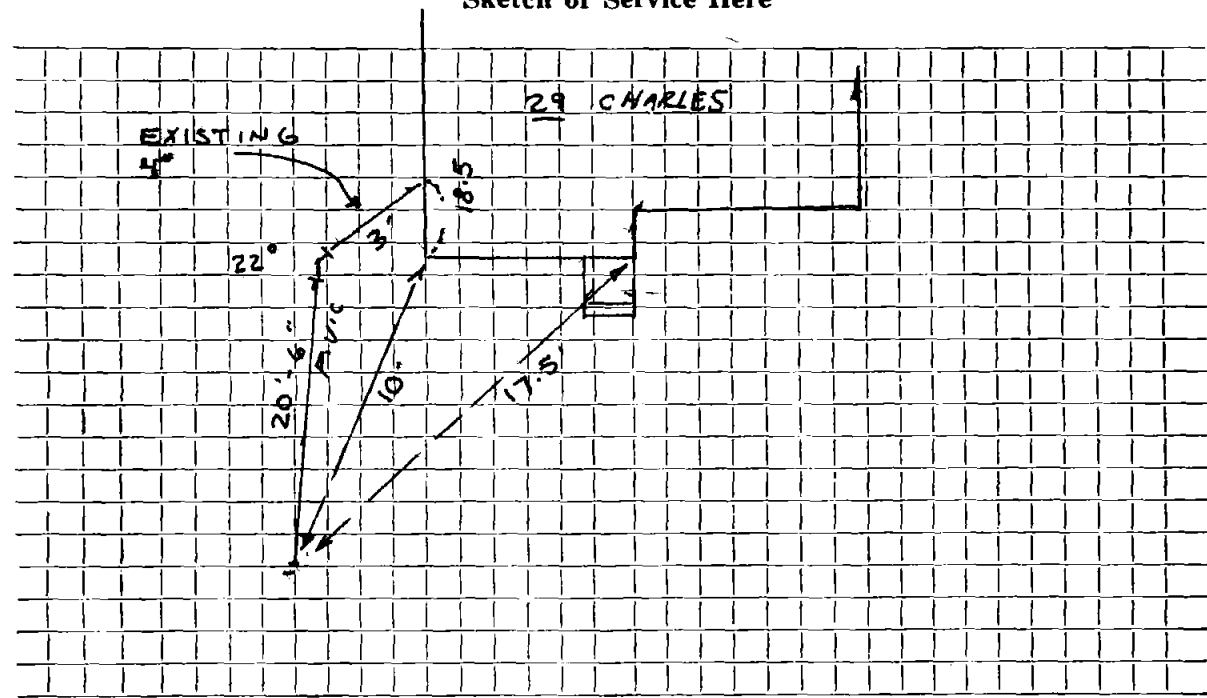

Connection made in CHARLES Street. Work completed ARLEX OIL

Remarks:

.....

.....

TOWN OF LEXINGTON—BOARD OF PUBLIC WORKS

SEWER DIVISION

DATE

July 12 1933

NO. _____


The undersigned applies for the construction of a particular sewer connecting No. _____ Street and hereby agrees to comply with the Rules and Regulations governing the construction and use of Particular Sewers, as now or at any future time established by the Board of Selectmen.

Am't. of Estimate \$ 33 10

Am't. Paid \$ 33 10

Wm. W. ... Owner

Sketch of Service Here

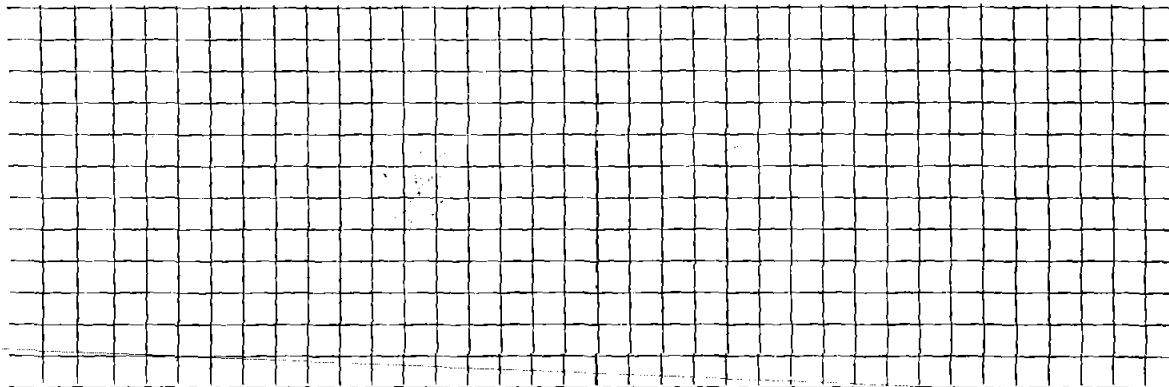

Connection made in _____ Street.

Work completed _____ 19

Remarks: